

WILKINSON

Ø 15

4-23-65

MISSISSIPPI BOARD OF WATER COMMISSIONERS

2709 2420

WATER WELL DRILLERS LOG

**CODED**

Date: 4-23, 1965, Driller: Chester Reeves County: White  
(Name)

(1) Owner of Land	Description & Color of Materials Sand, Clay, Red Clay, Shell, etc.	Thick- ness Feet	Depth Feet
<u>Edward M. Curley</u> (Name) <u>H-1, Gloster</u> (Address)	<u>Surface Clay</u>	<u>25</u>	<u>25</u>
	<u>fine sand</u>	<u>5</u>	<u>30</u>
(2) Location: <u>1/4</u> , <u>1/4</u> , Sec <u>5</u> <u>2<sup>N</sup> 1<sup>E</sup></u>	<u>white chalk</u>	<u>60</u>	<u>90</u>
<u>9</u> <u>west</u> <u>Gloster</u> (distance) (direction) of (Nearest Town)	<u>fine sand</u>	<u>27</u>	<u>117</u>
(3) Topography: <u>Hilly</u> (Hilly) (Flat) (Level)	<u>medium coarse sand</u>	<u>10</u>	<u>127</u>
(4) Purpose of Well: <u>Domestic</u> (Domestic Irrigation Municipal, Industrial, Other)			

Information upon completion of well:


- (1) Diameter 2 inches.
- (2) Total Depth 127 feet.
- (3) Water Level 60 feet below top of ground.
- (4) Cased to bottom, Size 2"
- (5) Screen: Size 1/4, Length 7'
- (6) Were any formations sealed against pollution?  
\_\_\_\_\_ yes,  no.

If YES depth of formation \_\_\_\_\_

Why \_\_\_\_\_

Drillers Remarks: old well inadequate

**CODED**

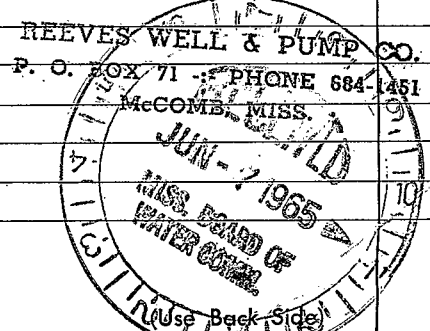

Well No.

1872

1872

