

WILKINSON
 017
 2-2-73

MISSISSIPPI
 BOARD OF WATER COMMISSIONERS
 416 North State Street
 Jackson, Mississippi 39201

WATER WELL DRILLERS LOG

CODED

Feb 2 1973 date well completed
 Cheatek Reeves firm name
 wilkinson county well located

LANDOWNER: Joann
McGraw Jr
RT 1, Centerville
 (mailing address)

WELL LOCATION:
 sec 34 T 2 N R 1 E
3 1/4 miles W of Centerville
 (distance) (direction) (nearest town)

WELL PURPOSE: House
 (home, irrigation, municipal, industrial)

WELL COMPLETION DATA:

- (1) diameter (inches) 4"
- (2) total depth (feet) 135
- (3) static water level (feet) 50 below top of ground.
- (4) casing Plast Ballam
 (material) (depth)
- (size) if telescope see back.
- (5) screen 6' 129'
 (length) (depth to top)
- 4" Plast
 (size) (material)
- (6) pump 1/2 HP 12
 (type power) (yield gpm)
- (7) electric log NO
 (yes or no)
- (organization running log)

description of formations encountered	from	to
Clay	0	16
Sand & Gravel	16	44
White Chalk	44	122
fine sand	122	130
Coarse sand	130	135


CODED

(8) how well bottom plugged
wooden plug

DRILLERS REMARKS:
old well not good

If well telescopes please sketch and show depths.

GROUND LEVEL

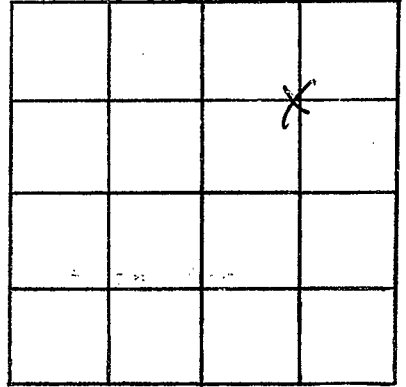

SECTION 34

Please indicate well location X.

ADDITIONAL INFORMATION

If more than one screen,
show locations of each on sketch.