

WILKINSON
Φ 18
8-8-73

MISSISSIPPI
 BOARD OF WATER COMMISSIONERS
 416 North State Street
 Jackson, Mississippi 39201

CODED

WATER WELL DRILLERS LOG

8-8 1973 *Quiner Water Well Service* Wilkinson
 date well completed firm name county well located

LANDOWNER:	description of formations encountered	from	to
<i>Greystone Farms</i> <i>Centerville, Miss.</i> (mailing address)			
	<i>red clay</i>	<i>2</i>	<i>6</i>
	<i>gray clay</i>	<i>6</i>	<i>115</i>
	<i>sand</i>	<i>115</i>	<i>131</i>
WELL LOCATION: sec. <i>18</i> T. <i>2</i> N. R. <i>1</i> E. S. <i>5</i> <i>5</i> miles <i>NW</i> of <i>Centerville</i> (distance) (direction) (nearest town)			
WELL PURPOSE: <i>Home</i> (home, irrigation, municipal, industrial)			
WELL COMPLETION DATA:			
(1) diameter (inches) <i>2"</i>			
(2) total depth (feet) <i>131'</i>			
(3) static water level (feet) <i>57'</i> below above top of ground.			
(4) casing <i>Gal.</i> <i>126'</i> (material) (depth) <i>2"</i> (size) if telescope see back.			
(5) screen <i>5'</i> <i>126'</i> (length) (depth to top) <i>2"</i> <i>"55"</i> (size) (material)			
(6) pump _____ (HP) _____ (yield gpm) (type power)			
(7) electric log <i>No</i> (yes or no) (organization running log)			
(8) how well bottom plugged <i>Wood Plug</i>			
DRILLERS REMARKS:			


CODED

UGI 721973

MISS. DEP. OF
 WATER CONTROL

If well telescopes please sketch and show depths.

GROUND LEVEL

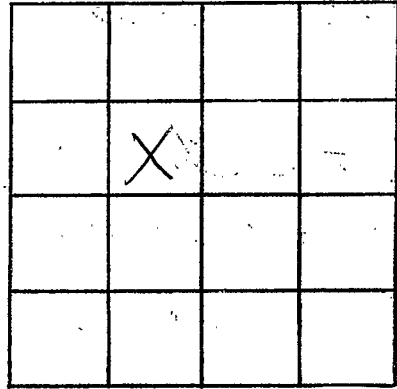

SECTION 18

Please indicate well location X.

ADDITIONAL INFORMATION

If more than one screen, show locations of each on sketch.