

WILKINSON
 19
 12-19-73

MISSISSIPPI
 BOARD OF WATER COMMISSIONERS
 416 North State Street
 Jackson, Mississippi 39201

CODED

WATER WELL DRILLERS LOG

Dec 19 1973 Chester Keenes Wilkinson
 date well completed firm name county well located

LANDOWNER: Edward M. Gentry
Rt 1, Glatter

description of formations encountered	from	to
chalk	0	18
white sand	18	44
white chalk	44	116
fine white sand	116	132

(mailing address)

WELL LOCATION:
 sec. 5 T 2 N R 1 E
6 miles NW of Porterville
 (distance) (direction) (nearest town)

WELL PURPOSE: same
 (home, irrigation, municipal, industrial)

WELL COMPLETION DATA:

- (1) diameter (inches) 4"
- (2) total depth (feet) 134
- (3) static water level (feet) 65 below above top of ground.
- (4) casing Plast Ballam
 (material) (depth)
- _____ if telescope see back.
 (size)
- (5) screen 6' 128'
 (length) (depth/to top)
- 4" Plast
 (size) (material)
- (6) pump sed jet pump
 (HP) (yield gpm)
- elect
 (type power)
- (7) electric log no
 (yes or no)
- _____ (organization running log)

CODED

(8) how well bottom plugged wooden plug


DRILLERS REMARKS:
2" well head

MAY 24 1974

MISS. BU. OF WATER COMMISSIONERS

If well telescopes please sketch and show depths.

GROUND LEVEL

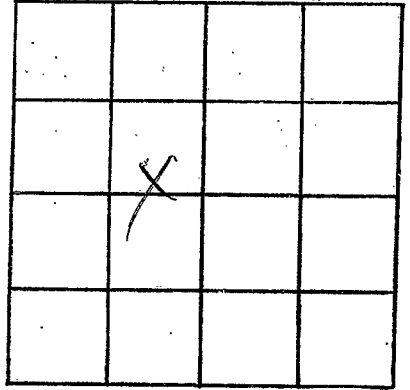

SECTION 05

Please indicate well location X.

ADDITIONAL INFORMATION

If more than one screen, show locations of each on sketch.