

WILKINSON
Φ 20
10/10/74

MISSISSIPPI
BOARD OF WATER COMMISSIONERS
 416 North State Street
 Jackson, Mississippi 39201

CODED


WATER WELL DRILLERS LOG

oct 10 1974 Chattanooga Wilkinson
 date well completed firm name county well located

LANDOWNER: <u>Henry Eugene Johnson</u> <u>RFD Centerville</u> (mailing address)	description of formations encountered	from	to
WELL LOCATION: sec <u>23</u> T <u>2</u> N R <u>1</u> E <u>1/4</u> miles <u>W</u> of <u>Centerville</u> (distance) (direction) (nearest town)	<u>clay</u> <u>Red sand</u>	<u>0</u> 62	<u>20</u> 62
WELL PURPOSE: <u>drain</u> (home, irrigation, municipal, industrial)	<u>sand gravel</u> <u>white gray chalk</u> <u>chalk with streaks of sand</u>	<u>62</u> <u>78</u> <u>78</u>	<u>78</u> <u>209</u> <u>209</u>
WELL COMPLETION DATA:	<u>blue chalk</u> CONCRETE	<u>209</u>	<u>220</u>
(1) diameter (inches) <u>4"</u> (2) total depth (feet) <u>285</u> (3) static water level (feet) <u>176</u> below top of ground.	<u>CONCRETE</u>	<u>220</u>	<u>278</u>
(4) casing <u>Plast Bellows</u> (material) (depth) (size) If telescope see back.			
(5) screen <u>6"</u> <u>279</u> (length) (depth to top) <u>1/2"</u> <u>Plast</u> (size) (material)			
(6) pump <u>3/4 HP</u> <u>10</u> (HP) (yield gpm) <u>Electric</u> (type power)			
(7) electric log <u>NO</u> (yes or no) (organization running log)			
(8) how well bottom plugged <u>wooden plug</u>			
DRILLERS REMARKS: <u>all 2" well had</u>	RECORDED INDEXED NOV 18 1974 MISS. Bd. OF WATER COMM.		

If well telescopes please sketch and show depths.

GROUND LEVEL

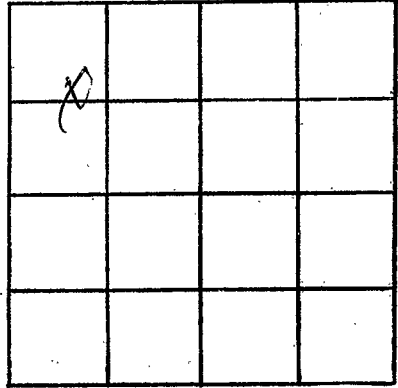

SECTION 23

Please indicate well location X.

ADDITIONAL INFORMATION

If more than one screen,
show locations of each on sketch.