

WILKINSON  
 021  
 3-8-74

MISSISSIPPI  
 BOARD OF WATER COMMISSIONERS  
 416 North State Street  
 Jackson, Mississippi 39201

CODED

WATER WELL DRILLERS LOG

March 8 1974 Chester Kerner Wilkinson  
 date well completed firm name county well located

LANDOWNER: Guy Decker  
 Centerville Miss.  
 (mailing address)

description of formations encountered	from	to
clay & gravel	0	16
red clay	16	36
red sand	36	68
chalk with streak of fine sand	68	182
coarse sand	182	190

WELL LOCATION:  
 sec. 28 T. 2 N. R. 1 E. D 146  
 S. 3 miles N-W of Centerville  
 (distance) (direction) (nearest town)

WELL PURPOSE: House  
 (home, irrigation, municipal, industrial)

- WELL COMPLETION DATA:
- (1) diameter (inches) 4"
  - (2) total depth (feet) 190
  - (3) static water level (feet) 75 below top of ground.
  - (4) casing Plast Bottom  
 (material) (depth)
  - (size) If telescope see back.
  - (5) screen 6' 184  
 (length) (depth to top)
  - 4" Plast  
 (size) (material)
  - (6) pump 3/4 sub 15  
 (HP) (yield gpm)
  - elect  
 (type power)
  - (7) electric log no  
 (yes or no)
  - (organization running log)
  - (8) how well bottom plugged wooden plug


CODED

RECEIVED  
 FEB 12 1975  
 MISSISSIPPI BOARD OF WATER COMMISSIONERS

DRILLERS REMARKS:  
 NW house

If well telescopes please sketch and show depths.

GROUND LEVEL

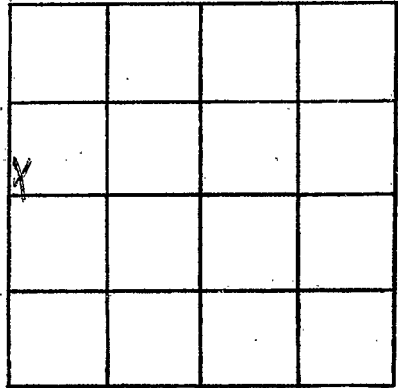

SECTION 28

Please indicate well location X.

ADDITIONAL INFORMATION

If more than one screen, show locations of each on sketch.