

Wilkinson
 022
 6-5-75

MISSISSIPPI
 BOARD OF WATER COMMISSIONERS
 416 North State Street
 Jackson, Mississippi 39201

CODED

WATER WELL DRILLERS LOG

June 5 19 *75* *Rever Well Drilling* *Wilkinson*
 date well completed firm name county well located

LANDOWNER:
Mrs. C. L. Pitchard
Rt 1 - Centerville
 (mailing address)

| description of formations encountered | from | to |
|---------------------------------------|-----------|-----------|
| <i>clay</i> | <i>0</i> | <i>18</i> |
| <i>Red sand</i> | <i>18</i> | <i>55</i> |
| <i>sand & gravel</i> | <i>55</i> | <i>70</i> |


WELL LOCATION:
 sec. *9* T. *2* N. R. *1* E. *14E*
4 1/2 miles *N-NW* of *Centerville*
 (distance) (direction) (nearest town)

WELL PURPOSE: *home*
 (home, irrigation, municipal, industrial)

- WELL COMPLETION DATA:
- (1) diameter (inches) *4"*
 - (2) total depth (feet) *70*
 - (3) static water level (feet) *56* below top of ground.
 - (4) casing *plastic* (material), *bottom* (depth)
 - (5) screen *6'* (length), *64* (depth to top)
 - (6) pump *1/2* (HP), *10* (yield gpm)
 - (7) electric log *no* (yes or no)
- (organization running log)

(8) how well bottom plugged
wooden plug


DRILLERS REMARKS:
new house site

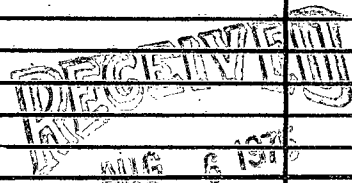

MISS. BD. OF WATER COMMISSIONERS

If well telescopes please sketch and show depths.

GROUND LEVEL

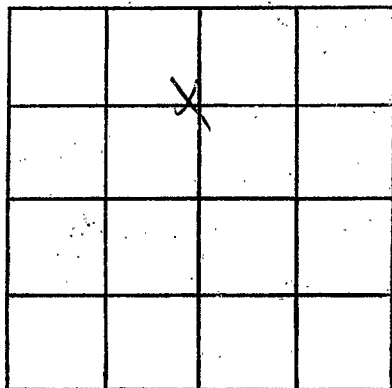

SECTION 9

Please indicate well location X.

ADDITIONAL INFORMATION

If more than one screen, show locations of each on sketch.