M	-	3-	5-	lЗ
1 1		\sim	-	~~

 
A : - 1	State Well Report	
county: AmiteWilkwor	Part 1 – Driller's Log	For Office Use Only
Desmit di	Mississippi Department of Environmental Q Office of Land and Water Resources	
Permit #: Driller: Etzgenuld hell Serce	P.O. Box 2309	Well #: <u>C 4 구</u>
Driller: <u>etterund wen Jus</u>	Jackson, MS 39225 (601)961- 5210	L. S. Elevation:
Date drilling completed: 1-28-13	(601)961-5228 (fax)	E-log #:
State Law requires that this repo	ے rt be prepared by the license holder responsi	
Department at the above addres Information on Well	s within 30 days of completion of drilling of	
(Landowner if borehole is not		ell or Borehole Location
Owner Name Wallace Brand.	Latitude: <u>37°° 7</u>	<u>30.9</u> Longitude: <u>908 2</u>
Mailing Address: Or. Andersch		(circle one): Conventional Survey,
maining Address: VI. HVQL+JcA k		and-held GPS, Survey-grade GPS
	NW KSF KG	ecTwn 2N_Rng / 1
<u>Claster MJ.</u> City Sta		
	<u> </u>	rection Nearest Town
Telephone No. ()		
Location of the source of any surface wat Method of dosing and volume of Chlorir Logs run (circle all applicable): No log ru		
Location of the source of any surface wat Method of dosing and volume of Chlorin Logs run (circle all applicable): No log ru Name of organization running log(s):	rilling completed: <u>1-28-13</u> . Hole depth: <u>13</u> er used for drilling: e used in drilling and development: m Electric Gamma Ray Density Sonic Ne	sutron Other:
Location of the source of any surface wat Method of dosing and volume of Chlorir Logs run (circle all applicable): No log ru Name of organization running log(s): Purpose of borehole (check one): Water V	rilling completed: 1-28-13. Hole depth: 13 er used for drilling: he used in drilling and development: m Electric Gamma Ray Density Sonic Ne /ellGeotechnical/Geological Investigation	sutron Other:
Location of the source of any surface wat Method of dosing and volume of Chlorir Logs run (circle all applicable): No log ru Name of organization running log(s): Purpose of borehole (check one): Water V Seismic	rilling completed: <u>1-28-13</u> . Hole depth: <u>13</u> er used for drilling: e used in drilling and development: m Electric Gamma Ray Density Sonic Ne	cutron Other: Ground Source Heat Pump
Location of the source of any surface wat Method of dosing and volume of Chlorin Logs run (circle all applicable): (o log re Name of organization running log(s): Purpose of borehole (check one): Water V Seismic If drilling is not related	rilling completed: <u>1-28-13</u> . Hole depth: <u>13</u> er used for drilling: we used in drilling and development: m Electric Gamma Ray Density Sonic Ne /ellGeotechnical/Geological Investigation SurveyOther (<i>describe</i>)	cutron Other: Ground Source Heat Pump of this block
Location of the source of any surface wat Method of dosing and volume of Chlorin Logs run (circle all applicable): (o log Tr Name of organization running log(s): Purpose of borehole (check one): Water V Seismic If drilling is not related Purpose of Well (check one): Home	rilling completed: 1-25-13. Hole depth: 13 er used for drilling: use used in drilling and development: m Electric Gamma Ray Density Sonic Ne Vell Geotechnical/Geological Investigation SurveyOther (describe) d to water well construction, skip the remainder of Industrial Public Supply Irrigation Fish	cutron Other: Ground Source Heat Pump of this block
Location of the source of any surface wat Method of dosing and volume of Chlorir Logs run (circle all applicable): Ko log Tr Name of organization running log(s): Purpose of borehole (check one): Water V Seismic If drilling is not related Purpose of Well (check one): Home If a flowing well, method of flow regulation	rilling completed: 1-28-13. Hole depth: 13 er used for drilling: ne used in drilling and development: n Electric Gamma Ray Density Sonic Ne Vell Geotechnical/Geological Investigation Survey Other (describe) d to water well construction, skip the remainder of Industrial Public Supply Irrigation Fish on: Valve Other (describe)	cutron Other: Ground Source Heat Pump of this block Culture Other:
Location of the source of any surface wat Method of dosing and volume of Chlorir Logs run (circle all applicable): to log Te Name of organization running log(s): Purpose of borehole (check one): Water V Seismic <i>If drilling is not relate</i> Purpose of Well (check one): Home If a flowing well, method of flow regulate Static Water Level: feet a	rilling completed: 1-28-13. Hole depth: 13 er used for drilling: he used in drilling and development: an Electric Gamma Ray Density Sonic Ne VellGeotechnical/Geological Investigation SurveyOther (describe) d to water well construction, skip the remainder of Industrial Public Supply Irrigation Fish on: Valve Other (describe) bove or below (circle one) land surface Date me	sutron Other:
Location of the source of any surface wat Method of dosing and volume of Chlorir Logs run (circle all applicable): Ko log re Name of organization running log(s): Purpose of borehole (check one): Water V Seismic If drilling is not related Purpose of Well (check one): Home If a flowing well, method of flow regulation Static Water Level: Method of Measurement (circle one)	rilling completed: 1-28-13. Hole depth: 13 er used for drilling: ne used in drilling and development: n Electric Gamma Ray Density Sonic Ne Vell_Geotechnical/Geological Investigation SurveyOther (describe) d to water well construction, skip the remainder of IndustrialPublic SupplyIrrigation Fish on: ValveOther (describe) bove or below (circle one) land surface Date me reference air line othe	cutron Other:
Location of the source of any surface wat Method of dosing and volume of Chlorir Logs run (circle all applicable): to log Te Name of organization running log(s): Purpose of borehole (check one): Water V Seismic If drilling is not related Purpose of Well (check one): Home If a flowing well, method of flow regulations Static Water Level: Method of Measurement (circle one) and Well depth: Well grouted to a difference of the source of the s	rilling completed: 1-28-13. Hole depth: 13 er used for drilling: he used in drilling and development: on Electric Gamma Ray Density Sonic Ne /ellGeotechnical/Geological Investigation SurveyOther (describe) d to water well construction. skip the remainder of industrialPublic SupplyIrrigation Fish on: ValveOther (describe) bove or below (circle one) land surface Date me reference air line othe epth of 10 feet Type of grout (circle one).	cutron Other: Ground Source Heat Pump of this block Culture Other: easured: / -28 - /3, r: Neat Cententy Bentonite Mix
Location of the source of any surface wat Method of dosing and volume of Chlorir Logs run (circle all applicable): to log Te Name of organization running log(s): Purpose of borehole (check one): Water V Seismic If drilling is not related Purpose of Well (check one): Home If a flowing well, method of flow regulation Static Water Level: Method of Measurement (circle one) Well depth: Well grouted to a di Casing length: Method Casing l	rilling completed: 1-28-13. Hole depth: 13 er used for drilling: ar Electric Gamma Ray Density Sonic Ne /ellGeotechnical/Geological Investigation SurveyOther (describe) d to water well construction, skip the remainder of IndustrialPublic Supply Irrigation Fish on: Valve Other (describe) bove or below (circle one) land surface terms of 10 feet for Type of grout (circle one) for mg diameter: inches Type of construction transmission transmis	cutron Other: Ground Source Heat Pump of this block Culture Other: easured: / -28 - /3, r: Neat Cententy Bentonite Mix
Location of the source of any surface wat Method of dosing and volume of Chlorir Logs run (circle all applicable): to log Te Name of organization running log(s): Purpose of borehole (check one): Water V Seismic If drilling is not related Purpose of Well (check one): Home If a flowing well, method of flow regulation Static Water Level: Method of Measurement (circle one) Well depth: Well grouted to a di Casing length: Method Casing l	rilling completed: 1-28-13. Hole depth: 13 er used for drilling: ar Electric Gamma Ray Density Sonic Ne /ellGeotechnical/Geological Investigation SurveyOther (describe) d to water well construction, skip the remainder of IndustrialPublic Supply Irrigation Fish on: Valve Other (describe) bove or below (circle one) land surface terms of 10 feet for Type of grout (circle one) for mg diameter: inches Type of construction transmission transmis	cutron Other: Ground Source Heat Pump of this block Culture Other: easured: / -2&-/3. r: Neat Centers, Bentonite Mix asing: $\mathcal{P}_{\mathcal{K}}$
Location of the source of any surface wat Method of dosing and volume of Chlorir Logs run (circle all applicable): (o log Tr Name of organization running log(s): Purpose of borehole (check one): Water V Seismic If drilling is not related Purpose of Well (check one): Home If a flowing well, method of flow regulated Static Water Level: feet a Method of Measurement (circle one) a Well depth: Well grouted to a d Casing length: feet Casi Screen length: feet Screen	rilling completed: 1-28-13. Hole depth: 13 er used for drilling: we used in drilling and development: me Electric Gamma Ray Density Sonic Net VellGeotechnical/Geological Investigation VellGeotechnical/Geological Investigation VellGeotechnical/Geological Investigation VellGeotechnical/Geological Investigation SurveyOther (describe) A to water well construction, skip the remainder of IndustrialOther (describe) Non: ValveOther (describe) bove or below (circle one) land surface Date me effet app electric tape air line other of 10 feet free Type of grout (circle one). Note mg diameter: 4''' inches Type of ca	sutron Other:
Location of the source of any surface wat Method of dosing and volume of Chlorin Logs run (circle all applicable): (o log Tr Name of organization running log(s): Purpose of borehole (check one): Water V Seismic If drilling is not related Purpose of Well (check one): Home If a flowing well, method of flow regulated Static Water Level: feet a Method of Measurement (circle one) a Well depth: Well grouted to a d Casing length: feet Casi Screen length: feet Screen Screen slot size:	rilling completed: $1 - 2\beta - 13$. Hole depth: 13 er used for drilling: use used in drilling and development: an Electric Gamma Ray Density Sonic Net VellGeotechnical/Geological Investigation VellGeotechnical/Geological Investigation SurveyOther (describe) d to water well construction. skip the remainder of industrialOther (describe) industrialOther (describe) for: ValveOther (describe) bove or below (circle one) land surface Date me test tape electric tape air line other epth of 10^- feet inches Type of co en diameter: $4^{\prime\prime\prime}$ inches Type of so	sutron Other: Ground Source Heat Pump of this block CultureOther: easured: $1 - 2\delta - 13$, r: Near Cements Bentonite Mix asing: $P_{L \ll}$ creen: $P_{L \ll}$ $0 = 13 c^{-1}$ feet

RECEIVED

MAR 01 2013

BY: OLWR


The sketch below only required for water wells



Description of formations encountered must be provided for all wells and boreholes, unless specifically exempted by regulations

	Description of Formations Encountered	From (depth)	To (depth)
		Ground Level	
	Cluy	0	20
	Cluff.	20	40
	Clayr	40	60
	Schro.	60	se
	Sand	80	100
	Curre Sand	100	130
		L	
	······································		
		ļ	
		ļ	
			l
	······································		<u> </u>
		ļ	<u> </u>]
			4
1		L	

If more than one screen, show location of each on sketch

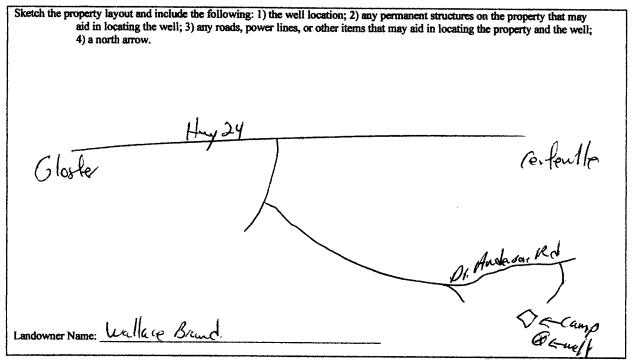

Form: OLWR-SWR-1A (04/08)

I certify that the well/borchole was drilled, constructed, and completed in accordance with all applicable requirements of the Mississippi Department of Environmental Quality and the Mississippi Department of Health regulations, if applicable, and state

laws <u>Bild J Edgeald</u> 044. <u>1-28-13</u>. Print Name of Responsible Licensee and License No. Date

Signature of Licensee

Sec Shely

RECEIVED

MAR 01 2013

BY: OLWR

County: <u>Acarte Wiltnen</u> Permit #: Driller: <u>Eutzgran ld Willde</u> . e. Date completed: <u>1-28-12</u> Proving 100 Proving	Well Location Well Location Latitude: 30° 2 36.5 # Sign 4" Longitude: 50° 2 36.5 # Sign 4" Longitude: 50° 2 36.5 # Method of Lat/Long (check one): Conventional Survey USGS quad Hand-held GPS NW 4 5E 4 Sec NW 4 5E 4 Sec		
Telephone No. ()	Distance Direction Mearest Town Miles Wey of Gloffer		
Pump Type Circle one Air Lift Jet Bucket Piston Centrifugal Rotary Flowing Well	Power Type Circle one Diesel Engine Gasoline Engine Natural Gas Electric Motor Hand Tractor PTO Windmill Other (specify):		
Centrifugal Rotary Flowing Well Other (specify):	Horse Power Rating of Motor:		
Date Pump Installed: 1-26-13. Rated Pump Capacity: 20 Gailons Per Minute	Setting Depth:		
Pump Test Data Date Well Tested:	Method of Measuring Water Level Circle one Air Line Electric Measuring Line Seet Tape Other (specify):		
This is for (circle one): New Well Replacement of Ex	Aisting Pump Repair of Existing Pump		
I HEREBY CERTIFY that the above statements are true to the best Brad Fitzera (d. 024- Print Name of Pump Installer and License No. (if applicable) RECEIVED MAR 0 1 2013 BY: OLWR			

• •

.

٠

٩.