	STATE WELL REPORT	310
ermit #: riller: <u>Fitzparald Wellfern</u> e	Part 1	For Office Use Only: Well #:
tate drilling completed: $12 - 13 - 14$.	(601)961-5555 (601)961-5228 (fax)	E-LOG #
State Law requires that this report b	e prepared by the license holder responsible for t	he work and filed with the
Department at the above address wit Well Owner Informatio	hin 30 days of completion of drilling of the well Well or Bore	chole Location
(Landowner if borehole is not for a	water well) Latitude: 31° 5 '44.5 Los	ngitude: <u>91° 6´ 24, 1⁴</u>
Dwner Name: <u>Bucky Dauden</u> Aailing Address: <u>Cane Creek R</u>	Method of Latricing (theth of	e): Conventional Survey,
.	USGS quad, Hand-held G	SPS, Survey-grade GPS
Centerville m 5 City State		36 TZN RIE
City State	(Distance) (Disaction)	of (Nearest Town)
	Well / Borehole Data	
	Irilling completed: <u>(2-(3-()</u> Hole depth:	
	e used in drilling and development:	
Name of organization running log(s):		,,,,,,, _
Purpose of borehole (check one): Water	Well Geotechnical/Geological Investigation	Ground Source Heat Pump
Seismi	c Survey Other (<i>describe</i>)	
If drilling is not rela	ted to water well construction, skip the remainde	er of this block
	Home Industrial Public Supply Irrigation	1151.71.78
	tion: Valve Other (<i>describe</i>)	
	above or below] land surface Date measu (check one)	
Method of measurement (check one)	teel tape Electric tape Air line Other (<i>describ</i> depth of: 19	e):
Well depth: <u>[18</u>] Well grouted to a	depth of: <u>General rype of grout (check one</u>	· · Puc
Casing length: <u>U</u> feet Ca	sing diameter: $\frac{q^{\prime\prime}}{q^{\prime\prime}}$ inches Type of	casing: <u>/ · · ·</u>
Screen length: <u>J0</u> feet So	creen diameter: <u>4"</u> inches Type of Setting depth: From <u>9</u>	f screen: <u></u>
Screen slot size: <u>, Oto</u> inches	Setting depth: From <u>97</u> feet e) Uravel packed Underreamed Open hole	to <u>10</u> feet
		-
Top of lap pipe or reduction in casing:	ped or more than one screen, describe on next p	


Form: OLWR-SWR-1A (4/13)

County:	
Permit #:	

For	Office	Use	Only:	

The sketch below only required for water wells

If well telescopes, show depths on sketch.

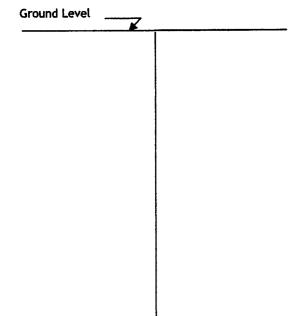

Description of formations encountered must be provided for all wells and boreholes, unless specifically exempted by regulations

Description of Formations Encountered	From (depth)	To (depth)
	Ground level	
Cluy-	Ŏ	20
Cluy- Gruzeli	20	40
Sand.	40	60
chij	Gu	80
Sand-	80 90	69
Coursesand	90	118

If more than one screen, show location of each on sketch

Sketch the property layout and include the following:

1) the well location

2) any permanent structures on the property that may aid in locating the well

3) any roads, power lines, or other items that may aid in locating the property and the well

4) north arrow

	PL.	0.1
Landowner Name:	DUCILY	Varden

I HEREBY CERTIFY that the well/borehole was drilled, constructed, and completed in accordance with all applicable requirements of the Mississippi Department of Environmental Quality and the Mississippi Department of Health regulations, if applicable, and state laws.

Bs BIAN FIZUAL 12-13-18. 029 Print Name of Responsible Licensee and License No. Date Signature of Licensee

$$\phi$$
55

Gogle Maps 31°05'44.5"N 91°06'24.1"W



Imagery ©2018 Google, Map data ©2018 Google 500 ft

RECEIVED DEC 2 1 2018 BY OLWR

https://www.google.com/maps/place/31%C2%B005'44.5%22N+91%C2%B006'24.1%22... 12/16/2018

STATE W	ELL REPORT	
County: P.Wilkinson	Part 2	For Office Use Only:
	r's Completion Report	, •
Permit #: Pump Installe Mississippi Departm Driller: <u>Fitzgerald Well Server</u> Office of La	nent of Environmental Quality nd and Water Resources	Well #:55
1-13-13-18 P	.O. Box 2309	Aquifer:
Jackse	on, MS 39225-2309 501)961-5210	Aquiter:
) 360-0535 (fax)	
This part of the report must be completed by a licensed water of the report must be attached and both parts filed with the L	well contractor or a licensed pur Department at the above address v	np installer. A copy of Part 1 vithin 30 days of well completion.
Well Owner Information	Well L	ocation
Owner Name: Bucky Parden	1	ngitude: 10°6 24,1''
Mailing Address: <u>Cance Creet-Rd</u>): Conventional Survey,
		PS, Survey-grade GPS
Centersille MS, City State Zip Code	<u></u>	36 TANRIE
	Miles (Distance) (Direction)	f
Telephone No. ()	(Distance) (Direction)	(Nearest Town)
Ритр Ту	pe (check <i>one</i>)	
Submersible Turbine Air Lift Centrifugal Flowing Well]Jet]Piston]Rotary]Dther (de	escribe):
Date Pump Installed:	Rated Pump Capacity:	Gallons Per Minute
Is This Pump (check one): New Repaired Replaceme		
Power Ty	pe (check one)	
Electric Dresel Gasoline Natural Gas	ndmill Other (describe):	
Horse Power Rating of Motor:	th:feet Numbe	r of Stages:
I Pump lest vala	for Non Flowing Well	
Date Well Tested:	for Non Flowing Well Duration of Pump Test (minin	num 4 hours): hours
	Duration of Pump Test (minin	num 4 hours): hours
Date Well Tested:	Duration of Pump Test (<i>minir</i> Pumping Water Level (B):	
Date Well Tested: Feet Below Land Surface Static Water Level (A): Feet Below Land Surface Drawdown [(B) - (A)]:Feet Below Land Sur	Duration of Pump Test (minin Pumping Water Level (B): Pumping Rate:	Feet Below Land Surface Gallons Per Minute
Date Well Tested: Feet Below Land Surface Static Water Level (A): Feet Below Land Surface Drawdown [(B) - (A)]: Feet Below Land Sur Method of measurement (check one): Steel tape Electric	Duration of Pump Test (minin Pumping Water Level (B): Pumping Rate:	Feet Below Land Surface Gallons Per Minute
Date Well Tested: Feet Below Land Surface Static Water Level (A): Feet Below Land Surface Drawdown [(B) - (A)]: Feet Below Land Sur Method of measurement (check one): Steel tape Electric	Duration of Pump Test (<i>minir</i> Pumping Water Level (B): rface Test Pumping Rate: tape 🗛 in tine 🗍 Other (<i>describe</i>):	Feet Below Land Surface Gallons Per Minute
Date Well Tested: Feet Below Land Surface Static Water Level (A): Feet Below Land Surface Drawdown [(B) - (A)]: Feet Below Land Sur Method of measurement (check one): Steel tape Electric Fump Test Data	Duration of Pump Test (<i>minir</i> Pumping Water Level (B): rface Test Pumping Rate: tape Air line Other (<i>describe</i>): ata for Flowing Well	Feet Below Land Surface Gallons Per Minute RECEIVED
Date Well Tested: Feet Below Land Surface Static Water Level (A): Feet Below Land Surface Drawdown [(B) - (A)]: Feet Below Land Sur Method of measurement (check one): Steel tape Electric Pump Test Da Measured shut in head:feet. Well yielded GPM with a drawdown of	Duration of Pump Test (<i>minir</i> Pumping Water Level (B): rface Test Pumping Rate: tape Air line Other (<i>describe</i>): ata for Flowing Well	Feet Below Land Surface Gallons Per Minute RECEIVED
Date Well Tested: Feet Below Land Surface Static Water Level (A): Feet Below Land Surface Drawdown [(B) - (A)]: Feet Below Land Sur Method of measurement (check one): Steel tape Electric Pump Test Data Measured shut in head:feet. Well yielded GPM with a drawdown of Meter	Duration of Pump Test (minin Pumping Water Level (B): frace Test Pumping Rate:	Feet Below Land Surface Gallons Per Minute RECEIVED hours of pumpins 2 1 2018
Date Well Tested: Feet Below Land Surface Static Water Level (A): Feet Below Land Surface Drawdown [(B) - (A)]: Feet Below Land Sur Method of measurement (check one): Steel tape Electric Pump Test Da Measured shut in head:feet. Well yielded GPM with a drawdown of	Duration of Pump Test (minin Pumping Water Level (B): fface Test Pumping Rate:	Feet Below Land Surface Gallons Per Minute RECEIVED hours of pumpins 2 1 2018 BY OLWR
Date Well Tested: Feet Below Land Surface Static Water Level (A): Feet Below Land Surface Drawdown [(B) - (A)]: Feet Below Land Sur Method of measurement (check one): Steel tape Electric Pump Test Da Measured shut in head:feet. Well yielded GPM with a drawdown of Meter Meter Manufacturer:	Duration of Pump Test (minin Pumping Water Level (B): rface Test Pumping Rate:	Feet Below Land Surface Gallons Per Minute RECEIVED hours of pumping 2 1 2018 BY OLWR
Date Well Tested: Feet Below Land Surface Static Water Level (A): Feet Below Land Surface Drawdown [(B) - (A)]: Feet Below Land Sur Method of measurement (check one): Steel tape Electric Pump Test Da Measured shut in head:feet. Well yielded GPM with a drawdown of Meter Manufacturer: Meter Model Number/Name:	Duration of Pump Test (minin Pumping Water Level (B): rface Test Pumping Rate:	Feet Below Land Surface Gallons Per Minute RECEIVED hours of pupping 21 2018 BY OLWR
Date Well Tested: Feet Below Land Surface Static Water Level (A): Feet Below Land Surface Drawdown [(B) - (A)]: Feet Below Land Sur Method of measurement (check one): Steel tape Electric in Pump Test Data Metasured shut in head:feet. Well yielded GPM with a drawdown of Meter Manufacturer: Meter Model Number/Name: Totalizer Register Unit and Multiplier Factor (AF x .001, gates)	Duration of Pump Test (minin Pumping Water Level (B): fface Test Pumping Rate:	Feet Below Land Surface Gallons Per Minute RECEIVED hours of pupping 21 2018 BY OLWR
Date Well Tested: Feet Below Land Surface Static Water Level (A): Feet Below Land Surface Drawdown [(B) - (A)]: Feet Below Land Sur Method of measurement (check one): Steel tape Electric Pump Test Da Measured shut in head:feet. Well yielded GPM with a drawdown of Meter Manufacturer: Meter Model Number/Name: Totalizer Register Unit and Multiplier Factor (AF x .001, ga Installation Date: Meter installed by:	Duration of Pump Test (minin Pumping Water Level (B): fface Test Pumping Rate:	Feet Below Land Surface Gallons Per Minute RECEIVED hours of pupping 21 2018 BY OLWR
Date Well Tested: Feet Below Land Surface Static Water Level (A): Feet Below Land Surface Drawdown [(B) - (A)]: Feet Below Land Sur Method of measurement (check one): Steel tape [Electric in Pump Test Data Measured shut in head:feet. Well yielded GPM with a drawdown of Meter Manufacturer: Meter Model Number/Name: Totalizer Register Unit and Multiplier Factor (AF x .001, gain Installation Date: Meter installed by: Is This Meter (check one): New Repaired Replacent Important: By submitting the above information you are Totalizer Meter installed by: Is This Meter (check one): New Repaired Replacent Important: By submitting the above information you are Totalizer Meter installed by: Meter instal	Duration of Pump Test (minin Pumping Water Level (B): frace Test Pumping Rate:	Feet Below Land Surface Gallons Per Minute RECEIVED hours of pupping 21 2018 BY OLWR
Date Well Tested: Feet Below Land Surface Static Water Level (A): Feet Below Land Surface Drawdown [(B) - (A)]: Feet Below Land Sur Method of measurement (check one): Steel tape [Electric in Pump Test Di Measured shut in head:feet. Well yielded GPM with a drawdown of Meter Manufacturer: Meter Manufacturer: Meter Model Number/Name: Totalizer Register Unit and Multiplier Factor (AF x .001, gr Installation Date: Meter installed by: Is This Meter (check one): New Repaired Replacent	Duration of Pump Test (minin Pumping Water Level (B): frace Test Pumping Rate:	Feet Below Land Surface Gallons Per Minute RECEIVED hours of pupping 21 2018 BY OLWR

Form:	OLWR-SWR-2A (4/	13)