

corrected on
12/17/68
J.R.

WILKINSON
Φ 2000
6-68

MISSISSIPPI
BOARD OF WATER COMMISSIONERS
416 North State Street
Jackson, Mississippi 39201

CODED

WATER WELL DRILLERS LOG

June 26 1968 J.T. Carington Wilkinson
date well completed firm name county well located

LANDOWNER: Alton Ballinson

description of formations encountered

from to

Centerville Miss
(mailing address)

clay 35
sand 35 60
chalk 60 85
sand 85 109

WELL LOCATION:

sec. 27 3 R-1 E
S W
_____ miles _____ of _____
(distance) (direction) (nearest town)

WELL PURPOSE: Home
(home, irrigation, municipal, industrial)

WELL COMPLETION DATA:

(1) diameter (inches) 4"

(2) total depth (feet) 109'

(3) static water level (feet) 80' below above top of ground.

(4) casing Plastic 103'
(material) (depth)

4" if telescope see back.
(size)

(5) screen 6' 109'
(length) (depth to top)

4" Plastic
(size) (material)

(6) pump 1/2 8
(HP) (yield gpm)


Ac
(type power)

(7) electric log _____
(yes or no)

(organization running log)


(8) how well bottom plugged wood

DRILLERS REMARKS:

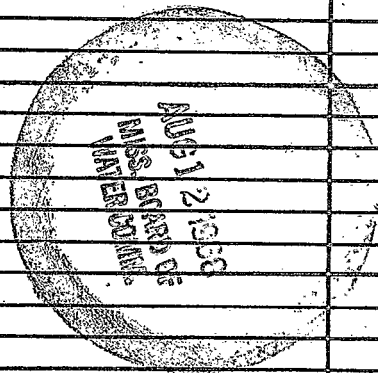

If well telescopes please sketch and show depths.

GROUND LEVEL

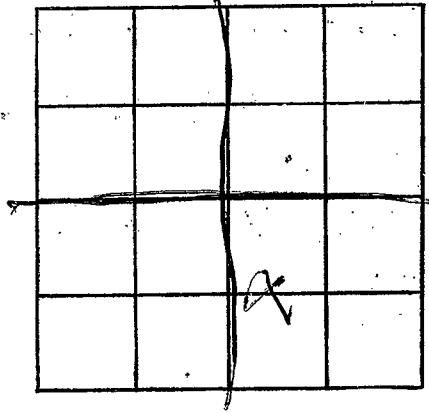

SECTION 27

Please indicate well location X.

ADDITIONAL INFORMATION

If more than one screen, show locations of each on sketch.