

Wilkinson  
 200  
 4-21-76

MISSISSIPPI  
 BOARD OF WATER COMMISSIONERS  
 416 North State Street  
 Jackson, Mississippi 39201


WATER WELL DRILLERS LOG

21 April 1976 J.T. Coyle & Son Wilkinson  
 date well completed firm name county well located

LANDOWNER:	description of formations encountered	from	to
D.Z. Hughes Centerville (mailing address)	clay clay sand clay clay sand	0	75 45 70 150 176
WELL LOCATION: sec. 28 T. 2 N. R. 1 E 1.1 miles N of Centerville (distance) (direction) (nearest town)			
WELL PURPOSE: (home, irrigation, municipal, industrial)			
WELL COMPLETION DATA: (1) diameter (inches) 4 (2) total depth (feet) 176 (3) static water level (feet) 100 below top of ground. (4) casing (material) pt (depth) 170 (size) if telescope see back. (5) screen (length) 6 (depth to top) 170 (size) 4 (material) pt (6) pump (HP) 1/2 (yield gpm) 8 (type power) elect (7) electric log (yes or no) (organization running log) (8) how well bottom plugged good			
DRILLERS REMARKS:	JUN 23 1976		

If well telescopes please sketch and show depths.

GROUND LEVEL

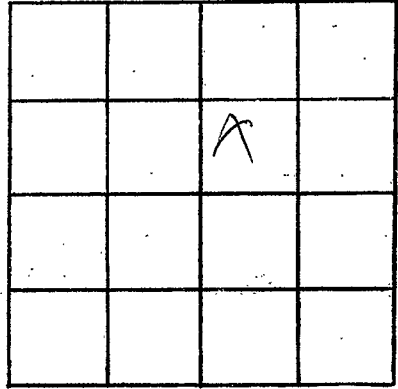

SECTION 28

Please indicate well location X.

ADDITIONAL INFORMATION

If more than one screen, show locations of each on sketch.