

WILKINSON

0 2003

4-15-78

MISSISSIPPI BOARD OF WATER COMMISSIONERS 416 North State Street Jackson, Mississippi 39201

WATER WELL DRILLERS LOG

April 15 1978 Reems Miller Wilkerson date well completed firm name county well located

LANDOWNER:

M. G. Ray P.O. Box 52929 Baton Rouge (mailing address)

Table with 4 columns: description of formations encountered, from, to. Rows include: Clay sand 0 26, Sand & gravel 26 50, Blue Chalk 50 140, Coarse sand 140 165

WELL LOCATION:

sec 32 T 2 N R 1 E 6 miles N-NW of Centerville (distance) (direction) (nearest town)

WELL PURPOSE: Route (home, irrigation, municipal, industrial)

WELL COMPLETION DATA:

- (1) diameter (inches) 4"
(2) total depth (feet) 165
(3) static water level (feet) 95 below top of ground
(4) casing Plastic bottom (material) (depth)
(5) screen 10' 15.5' (length) (depth to top)
(6) pump 1/2 HP 12 (HP) (yield gpm)
(7) electric log no (yes or no)

(organization running log)

(8) how well bottom plugged


DRILLERS REMARKS:

RECEIVED JUN - 8 1978

MISS. BD. OF WATER COMM

If well telescopes please sketch and show depths.

GROUND LEVEL

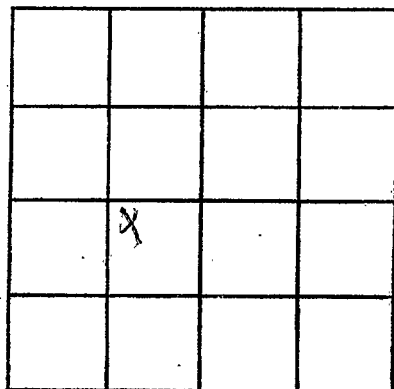

SECTION 32

Please indicate well location X.

ADDITIONAL INFORMATION

If more than one screen,
show locations of each on sketch.