

WILKINSON

0 8003

10-09-78

MISSISSIPPI BOARD OF WATER COMMISSIONERS 416 North State Street Jackson, Mississippi 39201

WATER WELL DRILLERS LOG

Oct. 9 1978 Brewer Miller Wilkinson date well completed firm name county well located

LANDOWNER: Mr. Leon Clark Rt Crosby (mailing address)

Table with 3 columns: description of formations encountered, from, to. Contains handwritten entries: clay, hard blue chalk, blue clay, sand & pea gravel, white chalk, sand & pea gravel with depth ranges.

WELL LOCATION: sec. 5 T 2 N R 1 E 8 miles N-NW of Centerville (distance) (direction) (nearest town)

WELL PURPOSE: Irrigation (home, irrigation, municipal, industrial)

- WELL COMPLETION DATA: (1) diameter (inches) 1 1/2" (2) total depth (feet) 235 (3) static water level (feet) 185 below top of ground. (4) casing plastic, bottom (material) (depth) (5) screen 1 1/2" 275 (length) (depth to top) 4 1/2" plastic (size) (material) (6) pump 1/2 HP 95 (yield gpm) (7) electric log NO (type power) (organization running log)

(8) how well bottom plugged Wooded pump DRILLERS REMARKS:


Miss. Board of Water Comm.

FEB 15 1979

RECEIVED

If well telescopes please sketch and show depths.

GROUND LEVEL

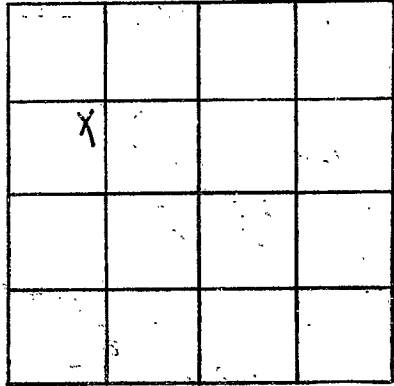

SECTION 5

Please indicate well location X.

ADDITIONAL INFORMATION

If more than one screen,  
show locations of each on sketch.