

WILKINSON

MISSISSIPPI  
BOARD OF WATER COMMISSIONERS  
416 North State Street  
Jackson, Mississippi 39201

0 2004

8-09-78

WATER WELL DRILLERS LOG

*WILKINSON*

Aug 9 1978  
date well completed

Reeves Miller  
firm name

county well located:


LANDOWNER:	description of formations encountered	from	to
Arain Mc Graw Jr.	Red Clay	0	77
Ati Crosley (mailing address)	Red sand gravel	17	60
WELL LOCATION:	White Chalk	60	126
sec. 31 T 2 N R 1 E	fine sand	126	135
4 miles NW of Centerville	med. coarse sand	135	150
(distance) (direction) (nearest town)			
WELL PURPOSE: home (home, irrigation, municipal, industrial)			
WELL COMPLETION DATA:			
(1) diameter (inches) 4"			
(2) total depth (feet) 150			
(3) static water level (feet) 90 below top of ground			
(4) casing plastic bottom (material) (depth)			
(size) if telescope see back.			
(5) screen 5" 145" (length) (depth to top)			
4" plastic (size) (material)			
(6) pump 1/2 HP 10 (HP) (yield gpm)			
shot (type power)			
(7) electric log no (yes or no)			
(organization running log)			
(8) how well bottom plugged			
Wood Plug			
DRILLERS REMARKS:			

RECEIVED  
DEC 29 1978

MISS. BD. OF WATER COMMISSIONERS

If well telescopes please sketch and show depths.

GROUND LEVEL

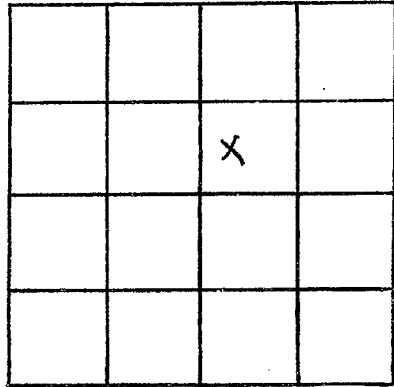

SECTION 31

Please indicate well location X.

ADDITIONAL INFORMATION

If more than one screen,  
show locations of each on sketch.