

MISSISSIPPI DEPARTMENT OF NATURAL RESOURCES

Bureau of Land and Water Resources

Southport Mall

P.O. Box 10631

Jackson, Mississippi 39209

WATER WELL DRILLERS LOG

Wilkinson  
0  
2005

Feb 5 1982  
 date well completed

Dr. Ernest Miller Wilkinson  
 firm name

county well located

LANDOWNER:

Mrs. Ernestine Pritchard  
Centerville  
 (mailing address)

description of formations encountered

from to

Clay	0	5
Red sand	5	10
Sand + gravel	10	17
White Chalk	17	20
Sand	20	25
White Chalk	25	28
Coarse sand	28	148

WELL LOCATION:

sec. 14 T 2 N R. 1 E  
3 miles north of Centerville  
 (distance) (direction) (nearest town)

WELL PURPOSE:

home  
 (home, irrigation, municipal, industrial)

WELL COMPLETION DATA:

- diameter (inches) 4"
- total depth (feet) 148
- static water level (feet) 95 below top of ground.
- casing plastic bottom  
 (material) (depth)  
 if telescope see back.  
 (size)
- screen 5' 143'  
 (length) (depth to top)  
4" plastic  
 (size) (material)
- pump used old pump  
 (HP) (yield/gpm)  
shot  
 (type power)
- electric log no  
 (yes or no)  
 (organization running log)

(8) how well bottom plugged  
back wash

DRILLERS REMARKS:


old well dry  
craft

DEPT. OF NATURAL RESOURCES  
 BUREAU OF LAND & WATER RESOURCES

JUL - 1 1982  
 RECEIVED

If well telescopes please  
sketch and show depths.

GROUND LEVEL

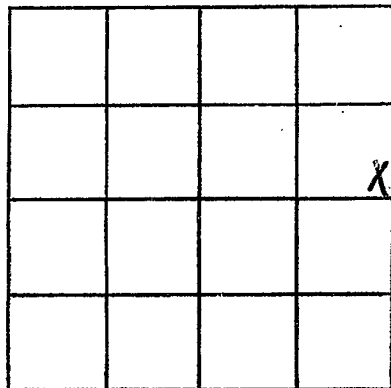

SECTION 14

Please indicate well location X.

ADDITIONAL INFORMATION

If more than one screen,  
show locations of each on sketch.