

MISSISSIPPI DEPARTMENT OF NATURAL RESOURCES

Bureau of Land and Water Resources

Southport Mall

P.O. Box 10631

Jackson, Mississippi 39209

WATER WELL DRILLERS LOG

Wilkinson
Φ 2014

8-3 1987 Fitzwell well by Wilkinson
 date well completed firm name county well located

LANDOWNER:	description of formations encountered	from	to
<u>Elizabeth Humphries</u>			
<u>R.B. Cantrellville, Mrs.</u> (mailing address)	<u>Red clay</u> <u>white & blue chalk</u> <u>Crease sand</u>	<u>0</u>	<u>20</u> <u>228</u> <u>246</u>
WELL LOCATION:			
sec. <u>23</u> T- <u>2</u> N R- <u>1</u> E S W			
<u>8</u> miles <u>SW</u> of <u>Cantrellville</u> (distance) (direction) (nearest town)			
WELL PURPOSE: <u>Home</u> (home, irrigation, municipal, industrial)			
WELL COMPLETION DATA:			
(1) diameter (inches) <u>4</u>			
(2) total depth (feet) <u>246</u>			
(3) static water level (feet) <u>175</u> below top of ground. above			
(4) casing <u>PVC</u> , <u>236</u> , (material) (depth) <u>4</u> if telescope see back. (size)			
(5) screen <u>10</u> , <u>236</u> (length) (depth to top) <u>4</u> , <u>PVC</u> (size) (material)			
(6) pump <u>3/4</u> , <u>10</u> (HP) (yield gpm) <u>elec</u> (type power)			
(7) electric log <u>No</u> (yes or no) <u>(organization running log)</u>			
(8) how well bottom plugged <u>Sand plug</u>			


RECEIVED
 AUG 21 1987

Department of Natural Resources
 Bureau of Land & Water Resources

DRILLERS REMARKS:

If well telescopes please sketch and show depths.

GROUND LEVEL

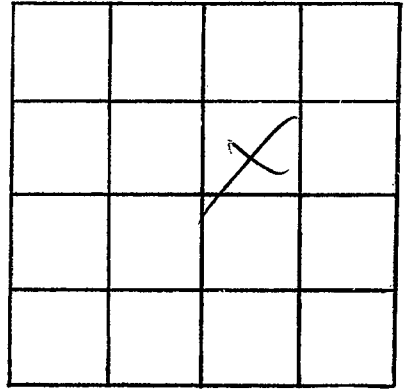

SECTION 23

Please indicate well location X.

ADDITIONAL INFORMATION

If more than one screen,
show locations of each on sketch.