

MISSISSIPPI DEPARTMENT OF ENVIRONMENTAL QUALITY

Office of Land and Water Resources

P. O. Box 10631

Jackson, MS 39289-0631

WATER WELL DRILLERS LOG

COUNTY WELL LOCATED
Wilkinson

WELL NUMBER
0-2026

DATE WELL COMPLETED
10-12-00

PERMIT NUMBER
079

NAME OF DRILLING FIRM
Reeves Well Ser

NAME & MAILING ADDRESS OF LANDOWNER
*Jewell Jack Darden
Madison Rd.
Centerville Miss.*

Latitude:
Longitude:

WELL LOCATION. SEC TOWNSHIP RANGE
28 2 S 1 W

DISTANCE DIRECTION NEAREST TOWN
1 Miles N of Centerville

OTHER LANDMARK

WELL PURPOSE: Home, Irrigation, Municipal, Industrial, Fish Pond, etc.

PUMP DATA

PUMP TYPE (Circle One):
Submersible, Turbine, Jet, Flowing Well,
Other (Describe) _____

POWER TYPE (Circle One):
Electric, Tractor, Diesel, Gasoline, Butane,
Other (Describe) _____ H/P *14*

DESCRIPTION OF FORMATIONS ENCOUNTERED	FROM	TO
<i>clay</i>	<i>0</i>	<i>15</i>
<i>red sand</i>	<i>15</i>	<i>50</i>
<i>clay sand & gravel</i>	<i>50</i>	<i>80</i>
<i>chalk</i>	<i>80</i>	<i>140</i>
<i>loamy sand</i>	<i>140</i>	<i>160</i>
<i>coarse sand</i>	<i>160</i>	<i>180</i>

WELL DATA

Well Depth *180'* Casing Diameter (In.) *4"* Casing Length (Ft.) *20'*

Type of Casing *PVC* Hole Depth *180'* Depth to Static Water Level *90'*

TYPE OF COMPLETION: (Circle One or More):
Gravel Packed, Underreamed, Telescoped,
Natural Development, Open Hole, Other
(Describe) *10 Gal. sand*

WELL GROUTED TO A DEPTH OF 10 FEET
Type Grout (circle one): Cement, Bentonite, or Mix

SCREEN DATA

Diameter - Inches *4"* Length - Feet *10'* Slot Size - Inches *10/32*

Screen Type *PVC* Depth to Bottom - Feet *180"*

RECEIVED

FEB 27 2001

BY: OLWR

Top of Lap Pipe or Reduction in Casing

FEET IF TELESCOPED OR MORE THAN ONE SCREEN: USE BACK PAGE

I certify that the well was drilled, constructed and completed in accordance with all applicable Requirements of the Mississippi Department of Environmental Quality and/or the Mississippi Department of Health regulations and state laws.


Jimmy Reeves *0668*
Signature of Licensed Driller and License No.

10-12-00
Date

Additional Information Required On Back

If well telescopes please sketch and show depths.

GROUND LEVEL

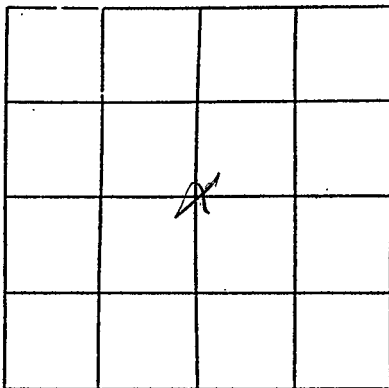

SECTION 28

Please indicate well location X.

Pump Capacity (GPM)	No. of Stages	Setting Depth
<u>10</u>	<u>12</u>	<u>120</u> FT.
PUMP TEST		
Well yielded <u>50</u> GPM with		
a drawdown of <u>0</u> ft.		
after <u>1</u> hours of pumping		

LOG DATA

TYPE OF LOG RUN (Circle One): No Log Run,
Electric, Gamma Ray, Density, Sonic, Neutron,
Other (Describe) _____

Name of Organization Running Log _____

GEOLOGIC DATA (Office Use Only)

Surface Elev.	Geologic Unit	Unit Thickness	Depth to Top
Subs. SWL	Date	Analysis	Aquifer Test

Driller's Remarks

If more than one screen, show location of each on sketch.