

WILKINSON
P I
12-20-72

MISSISSIPPI
BOARD OF WATER COMMISSIONERS
416 North State Street
Jackson, Mississippi 39201

CODED

WATER WELL DRILLERS LOG

12-20
date well completed

1972
firm name

Triners Water Well
Wilkinson
county well located

LANDOWNER:

St. Matthews Baptist Church
c/o William Heubis
Rt # 2 Box 730 - Woodville
(mailing address)

description of formations
encountered

top soil
red clay
gray clay
sand

from

to

0 2
2 8
8 48
48 91

WELL LOCATION:

sec. 16 T. 1 N. R. 4 E
3 miles SE of Pond
(distance) (direction) (nearest town)

WELL PURPOSE: Municipal
(home, irrigation, municipal, industrial)

WELL COMPLETION DATA:

- (1) diameter (inches) 2"
- (2) total depth (feet) 91'
- (3) static water level (feet) 70' below above top of ground.
- (4) casing Sub. 84'
(material) (depth)
2" (size) if telescope see back.
- (5) screen 5' 84'
(length) (depth to top)
2" (size) "55" (material)
- (6) pump 1 56 gpm
(HP) (yield gpm)
elec (type power)
- (7) electric log NO
(yes or no)

(organization running log)


(8) how well bottom plugged Wood Pole

JAN 23 1973

DRILLERS REMARKS:

If well telescopes please sketch and show depths.

GROUND LEVEL

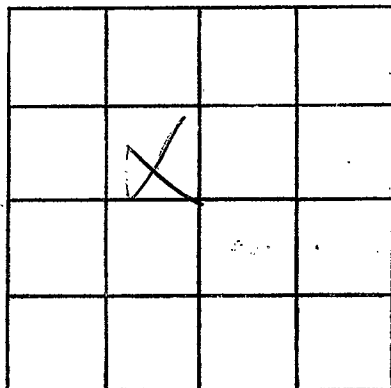

SECTION 16

Please indicate well location X.

ADDITIONAL INFORMATION

If more than one screen,
show locations of each on sketch.