


MISSISSIPPI DEPARTMENT OF NATURAL RESOURCES
 Bureau of Land and Water Resources
 Southport Mall
 P.O. Box 1063
 Jackson, Mississippi 39209

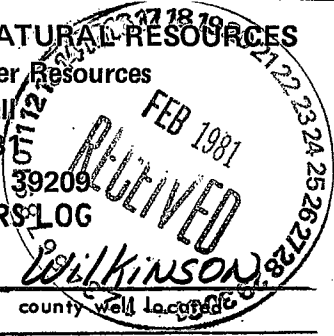

CODED

WATER WELL DRILLERS LOG

Griner Drilling Service, Inc.

WILKINSON
 county well location

WILKINSON
 P5
 Elog # 160
 2-5-81

#21
 date well completed

firm name

LANDOWNER:
 Amoco Production
 P.O. Box 51921
 Lafayette, La. 70505
 (mailing address)

description of formations encountered	from	to
Fill	0	35
sand + gravel	35	119
sand + clay	119	140
clay	140	182
sand	182	203
clay, sand, rock	203	308
clay + gravel	308	329
sand	329	371
sand clay	371	400

WELL LOCATION: 426' S + 1541' W of
 No 1 sep 1 T 1 (N) R 4 E (W) NE/CO
 Ovid B. Pond
 distance miles (direction) of (nearest town)

WELL PURPOSE: oil field supply
 (home, irrigation, municipal, industrial)

WELL COMPLETION DATA:

- (1) diameter (inches) 6"
- (2) total depth (feet) 400'
- (3) static water level (feet) 300' (below top of ground)
- (4) casing steel 300' (material) (depth)
 6" (size) if telescope see back.
- (5) screen 40' 350' (length) (depth to top)
 6" stainless steel (material) screen
- (6) pump 15 HP 50 (HP) (yield gpm)
 460 Volt 3 phase (type power)
- (7) electric log YES (logs or no)
 Ms. Geological Survey (organization running log)
- (8) how well bottom plugged 6" wood plug - backwash valve

DEPT. OF NATURAL RESOURCES
 BUREAU OF LAND & WATER RESOURCES

FEB 20 1981


RECEIVED

DRILLERS REMARKS:



If well telescopes please sketch and show depths.

GROUND LEVEL

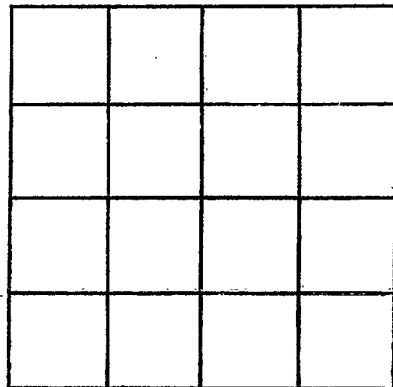

SECTION _____

Please indicate well location X.

ADDITIONAL INFORMATION

If more than one screen,
show locations of each on sketch.