

MISSISSIPPI DEPARTMENT OF NATURAL RESOURCES

Bureau of Land and Water Resources


Southport Mall

P.O. Box 10631

Jackson, Mississippi 39209

WATER WELL DRILLERS LOG

Griner Drilling Service, Inc.

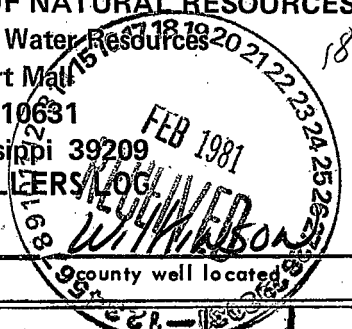

WILKINSON
P6
Elog 161
2/5/81
2-5-81

CODED

date well completed

firm name

LANDOWNER:

Amoco Production
P.O. Box 51921
Lafayette, MS
(mailing address)

description of formations encountered

from

to

clay & sand	0	21
sand	21	42
sand	42	63
sand, clay	63	84
clay, sand	84	105
clay, sand	105	126
chalk	126	147
chalk, sand	147	168
sand	168	189
streaked	189	210
chalk, sand	210	252
chalk	252	273
chalk, rock	273	336
chalk, rock	336	357
sand	357	462
sand, clay	462	483
clay, rock	483	504
clay, sand	504	525
sand, gravel	525	546
sand, clay	546	562
clay, sand	562	581

WELL LOCATION:

426' S & 1541' W

sec. LT 10 R 4E of

No. 1 B. Pond
over 1/2 mile
will be 21

ONE/4 of

1/4 mile of (direction) of (nearest town)

WELL PURPOSE: oil field supply
(home, irrigation, municipal, industrial)

WELL COMPLETION DATA:

#2 Well

(1) diameter (inches) 6"
(2) total depth (feet) 581'

(3) static water level (feet) 300' below top of ground.

(4) casing steel, 472' (material) (depth)

6" (size) if telescope see back.

(5) screen 60', 412' (length) (depth to top)

6" (size) stainless steel screen

(6) pump 15 (HP) 150 (yield gpm)

15 H.P. 460 volt (type power) 3 phase

(7) electric log yes (yes or no)

Ms. Geol. (organization running log)

(8) how well bottom plugged 6" wood plug, backwash valve

DRILLERS REMARKS:

DEPT. OF NATURAL RESOURCES
BUREAU OF LAND & WATER RESOURCES

FEB 20 1981

RECEIVED

