

WILKINSON
 P7
 12-12-81

MISSISSIPPI DEPARTMENT OF NATURAL RESOURCES
 Bureau of Land and Water Resources
 Southport Mall
 P.O. Box 10631
 Jackson, Mississippi 39209
 WATER WELL DRILLERS LOG

CODED

12-12-81 date well completed
 1981 Program Drilling firm name
 Wilkinson county well located

LANDOWNER:
 B. G. Fortenberry
 PEX PET Co.
 (mailing address)

description of formations encountered	from	to
	top soil	0
gravel	10	30
gumbo	30	380
sand	380	420
gumbo	420	500
sand	500	580

WELL LOCATION:
 sec. 6 T 1 N R 4 E
 1/2 miles E of Ponds
 (distance) (direction) (nearest town)

WELL PURPOSE:
 (home, irrigation, municipal, industrial)

- WELL COMPLETION DATA:
- (1) diameter (inches) 3"
 - (2) total depth (feet) 580'
 - (3) static water level (feet) 250' below top of ground.
 - (4) casing Blk. 560'
 (material) (depth)
3" if telescope see back.
 (size)
 - (5) screen 30' 560'
 (length) (depth to top)
3" slotted pipe
 (size) (material)
 - (6) pump 52 gpm
 (HP) (yield gpm)
 (type power)
 - (7) electric log no
 (yes or no)
 (organization running log)
 - (8) how well bottom plugged wood plug

Well #1
 CODED
 Fr SE/CR Sec. 6 go
 NEly alg Sec. 12
 7722' th NWly o RA
 7730' to loc in Sec 6

DEPT. OF NATURAL RESOURCES
 BUREAU OF LAND & WATER RESOURCES


DEC 17 1981

RECEIVED

DRILLERS REMARKS:

If well telescopes please
sketch and show depths.

GROUND LEVEL

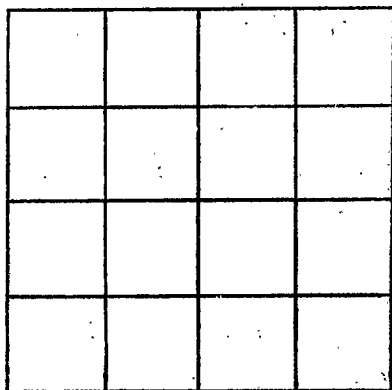

SECTION _____

Please indicate well location X.

ADDITIONAL INFORMATION

If more than one screen,
show locations of each on sketch.