

MISSISSIPPI DEPARTMENT OF NATURAL RESOURCES

Bureau of Land and Water Resources

Southport Mall

P.O. Box 10631

Jackson, Mississippi 39209

WATER WELL DRILLERS LOG

CODED

Wilkinson
P8
12-20-81

12-20-81 date well completed 81 Roughman Drilling firm name Wilkinson county well located

LANDOWNER: Ruhl Drilling
Natchez, MS 39120
 (mailing address)

description of formations encountered	from	to
top soil	0	2'
sand	2'	110'
gumbo	110'	405'
sand	405'	420'
gumbo	420'	565'

WELL LOCATION:
 sec. 6 T. 1 N. R. 4 E. S. W
1/2 miles E of Pond
 (distance) (direction) (nearest town)

WELL PURPOSE:
 (home, irrigation, municipal, industrial)

WELL COMPLETION DATA:

(1) diameter (inches) 3"

(2) total depth (feet) 405'

(3) static water level (feet) 260' ^{below} 260' _{above} top of ground.

(4) casing slipcase, 585'
 (material) (depth)
3" if telescope see back.
 (size)

(5) screen 20' 585'
 (length) (depth to top)
3" slotted pipe
 (size) (material)

(6) pump — 50
 (HP) (yield gpm)
elec
 (type power)

(7) electric log —
 (yes or no)
 (organization running log)

(8) how well bottom plugged Woodpile

Well # **CODED**
 Fr SE/Cor Sec. 6 go NE 1/4
 alg. Sec. 12 2224th NW 1/4 RA
 2738' to loc in Sec. 6

DEPT. OF NATURAL RESOURCES
 BUREAU OF LAND & WATER RESOURCES


DEC 28 1981

RECEIVED

DRILLERS REMARKS:

If well telescopes please
sketch and show depths.

GROUND LEVEL

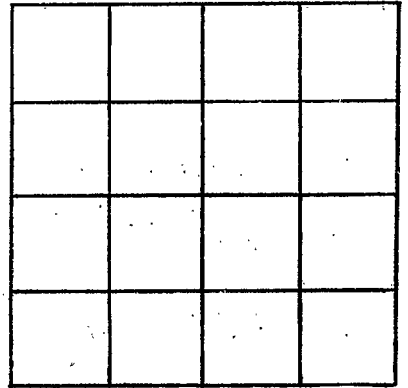

SECTION _____

Please indicate well location X.

ADDITIONAL INFORMATION

If more than one screen,
show locations of each on sketch.