

MISSISSIPPI DEPARTMENT OF NATURAL RESOURCES

Bureau of Land and Water Resources

Southport Mall

P.O. Box 10631

Jackson, Mississippi 39209

WATER WELL DRILLERS LOG

CODED

pg  
Wilkinson  
9-25-83

9-25 19 83 Rayborn Drill. & Const. Co. Wilkinson  
date well completed firm name county well located

LANDOWNER:	description of formations encountered	from	to
<u>Shamrock Drilling Co.</u>	<u>Top soil</u>	<u>0</u>	<u>10</u>
<u>Natchez, MS 39120</u> (mailing address)	<u>sand</u>	<u>10</u>	<u>20</u>
WELL LOCATION:	<u>sand &amp; shale</u>	<u>20</u>	<u>220</u>
sec. <u>12</u> T. <u>10</u> S. R. <u>4</u> E. <u>W</u>	<u>sand</u>	<u>220</u>	<u>245</u>
(distance) miles (direction) of (nearest town)	<u>shale</u>	<u>245</u>	<u>250</u>
WELL PURPOSE: (home, irrigation, municipal, industrial)	<u>sand</u>	<u>250</u>	<u>285</u>
WELL COMPLETION DATA:	<u>sand &amp; shale</u>	<u>285</u>	<u>430</u>
(1) diameter (inches) <u>3"</u>	<u>sand</u>	<u>430</u>	<u>465</u>
(2) total depth (feet) <u>465'</u>			
(3) static water level (feet) <u>200'</u> below above top of ground.			
(4) casing <u>Blk. 445'</u> (material) (depth)			
<u>3"</u> (size) if telescope see back.	<u>Clark Creek #1</u>		
(5) screen <u>20'</u> <u>445'</u> (length) (depth to top)	<u>FW 112/100 512, 20</u>		
<u>3"</u> (size) <u>slotted pipe</u> (material)	<u>W. 100 512, 20</u>		
(6) pump <u>52 GPM</u> (HP) (yield gpm)	<u>415 @ LA 115' 20</u>		
(type power)	<u>Lot in B12-11-10</u>		
(7) electric log <u>no</u> (yes or no)			
(organization running log)			
(8) how well bottom plugged <u>wood plug</u>			

DRILLERS REMARKS:


DEPT. OF NATURAL RESOURCES  
BUREAU OF LAND AND WATER RESOURCES

SEP 27 1983

RECEIVED

If well telescopes please sketch and show depths.

GROUND LEVEL

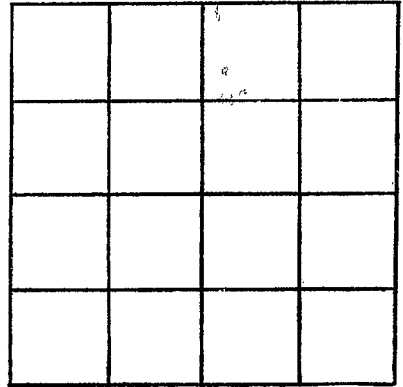

SECTION \_\_\_\_\_

Please indicate well location X.

ADDITIONAL INFORMATION

If more than one screen, show locations of each on sketch.