

MISSISSIPPI DEPARTMENT OF NATURAL RESOURCES

Bureau of Land and Water Resources

Southport Mall

P.O. Box 10631

CODED

Jackson, Mississippi 39209

WATER WELL DRILLERS LOG

WILKINSON
P10
9/2/83

9/2/83 19
date well completed

Rayburn Drilling
firm name

Wilkinson
county well located

LANDOWNER:
B. L. Fortenberry
Natchez, Miss.
(mailing address)

description of formations encountered	from	to
<i>Top Soil</i>	<i>0</i>	<i>2</i>
<i>River Sand</i>	<i>3</i>	<i>90</i>
<i>Sand</i>	<i>91</i>	<i>120</i>

WELL LOCATION:
sec. 11 T. 10 N. R. 4 E
2 miles *South* of *Et Adams*
(distance) (direction) (nearest town)

WELL PURPOSE: *oil field*
(home, irrigation, municipal, industrial)

- WELL COMPLETION DATA:
- (1) diameter (inches) 3"
 - (2) total depth (feet) 120'
 - (3) static water level (feet) 20' below above top of ground.
 - (4) casing PVC, 100'
(material) (depth)
3" if telescope see back.
(size)
 - (5) screen 20', 120'
(length) (depth to top)
3", PVC
(size) (material)
 - (6) pump —, 50 GPM
(HP) (yield gpm)
—
(type power)
 - (7) electric log NO
(yes or no)
—
(organization running log)
 - (8) how well bottom plugged Wood plug

CODED

DEPT. OF NATURAL RESOURCES
BUREAU OF LAND & WATER RESOURCES


NOV 28 1983

RECEIVED

DRILLERS REMARKS:

If well telescopes please sketch and show depths.

GROUND LEVEL

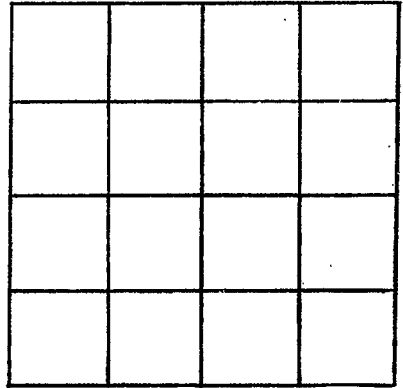

SECTION _____

Please indicate well location X.

ADDITIONAL INFORMATION

If more than one screen,
show locations of each on sketch.