

MISSISSIPPI DEPARTMENT OF NATURAL RESOURCES

Bureau of Land and Water Resources

Southport Mall

P.O. Box 10631

Jackson, Mississippi 39209

WATER WELL DRILLERS LOG

CODED

PRZ
 Wilkinson Co
 2-16-84

2-16 1984 Rayleorn Drill. & Const. Co. Wilkinson
 date well completed firm name county well located

LANDOWNER:	description of formations encountered	from	to
R. L. Williams Drill. Co.	Top soil	0	20
Memphis, Tennessee (mailing address)	sand & gravel	21	155
WELL LOCATION:	gumbo CODED	156	450
sec. 4 T 1 N R 4 E 4 S W 4 miles E of Pond (distance) (direction) (nearest town)	streak sand	451	495
WELL PURPOSE: <u>Dikefield</u> (home, irrigation, municipal, industrial)	sand	496	510
WELL COMPLETION DATA:			
(1) diameter (inches) <u>3"</u>			
(2) total depth (feet) <u>510'</u>			
(3) static water level (feet) <u>210'</u> below above top of ground.			
(4) casing <u>Belk</u> <u>490'</u> (material) (depth) <u>3"</u> (size) if telescope see back.			
(5) screen <u>20'</u> <u>490'</u> (length) (depth to top) <u>3"</u> <u>slotted ppe</u> (size) (material)			
(6) pump <u>—</u> <u>526 gpm</u> (HP) (yield gpm) <u>—</u> (type power)			
(7) electric log <u>no</u> (yes or no) <u>—</u> (organization running log)			
(8) how well bottom plugged <u>Wood Plug</u>			
DRILLERS REMARKS:			


DEPT OF NATURAL RESOURCES
 BUREAU OF LAND & WATER RESOURCES

APR 12 1984

RECEIVED

If well telescopes please sketch and show depths.

GROUND LEVEL

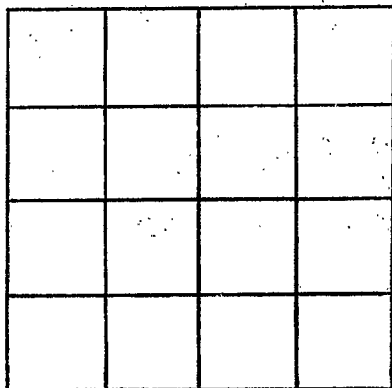

SECTION _____

Please indicate well location X.

ADDITIONAL INFORMATION

If more than one screen, show locations of each on sketch.