

WILKINSON  
P15

MISSISSIPPI DEPARTMENT OF NATURAL RESOURCES  
Bureau of Land and Water Resources  
Southport Mall  
P.O. Box 10631  
Jackson, Mississippi 39209  
WATER WELL DRILLERS LOG

CODED

7/16/84 Bayborn Drilling Wilkinson  
date well completed firm name county well located

LANDOWNER: Bill Martin  
Box 136  
H Adams, ms 39103  
(mailing address)

description of formations encountered	from	to
Chalk	0	90
Sand	91	96
Shale	97	190
Fine Sand	191	201
Shale	202	390
Sand	391	410

WELL LOCATION:  
sec. 26 T. 10 N. R. 4 E.  
1 miles North of H Adams  
(distance) (direction) (nearest town)

WELL PURPOSE: private  
(home, irrigation, municipal, industrial)

- WELL COMPLETION DATA:
- diameter (inches) 4"
  - total depth (feet) 410'
  - static water level (feet) 20' below top of ground. CODED
  - casing PVC pipe, 390'  
(material) (depth)  
4" (size) If telescope see back.
  - screen 20', 390'  
(length) (depth, to top)  
4" PVC slotted pipe (size) (material)
  - pump 3 55  
(HP) (yield gpm)  
electric (type power)
  - electric log no  
(yes or no)  
(organization running log)
  - how well bottom plugged wood


DRILLERS REMARKS:

DEPT. OF NATURAL RESOURCES  
BUREAU OF LAND & WATER RESOURCES

RECEIVED  
OCT 31 1984

If well telescopes please  
sketch and show depths.

GROUND LEVEL

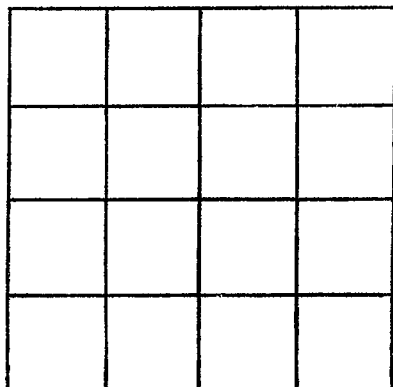

SECTION \_\_\_\_\_

Please indicate well location X.

ADDITIONAL INFORMATION

If more than one screen,  
show locations of each on sketch.