

WILKINSON

P 2000

6-17-77

MISSISSIPPI
BOARD OF WATER COMMISSIONERS
416 North State Street
14E Jackson, Mississippi 39201

WATER WELL DRILLERS LOG

6-17

date well completed

19-22 Rayburn Drill. & Const. Co. Wilkinson

firm name

county well located

LANDOWNER:	description of formations encountered	from	to
<u>Luanell Williams</u> <u>Rt #2 Box 685</u> <u>Woodville, Miss.</u> (mailing address)			
WELL LOCATION: sec <u>42</u> T <u>1</u> <u>N</u> R <u>4</u> <u>E</u> <u>1 1/2</u> miles <u>S</u> of <u>Pineknobville</u> (distance) (direction) (nearest town)	<u>brown clay</u>	<u>2</u>	<u>6</u>
WELL PURPOSE: <u>Home</u> (home, irrigation, municipal, industrial)	<u>blue clay</u>	<u>2</u>	<u>140</u>
WELL COMPLETION DATA: (1) diameter (inches) <u>2"</u> (2) total depth (feet) <u>250'</u> (3) static water level (feet) <u>90'</u> below above top of ground. (4) casing <u>PVC</u> , <u>239'</u> (material) (depth) <u>2"</u> if telescope see back. (size) (5) screen <u>10'</u> , <u>239'</u> (length) (depth to top) <u>2"</u> , <u>PVC</u> (size) (material) (6) pump <u>1/2</u> , <u>590pm</u> (HP) (yield/gpm) <u>elec</u> (type power) (7) electric log <u>no</u> (yes or no) (organization running log) (8) how well bottom plugged <u>wood plug</u>	<u>fine sand</u>	<u>140</u>	<u>150</u>
	<u>grey clay</u>	<u>150</u>	<u>220</u>
	<u>sand</u>	<u>220</u>	<u>250</u>
DRILLERS REMARKS:			


RECEIVED

SEP 20 1977

MISS. BD. OF WATER COMM

If well telescopes please sketch and show depths.

GROUND LEVEL

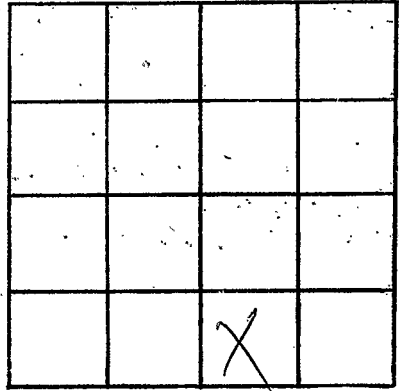

SECTION 42

Please indicate well location X.

ADDITIONAL INFORMATION

If more than one screen, show locations of each on sketch.