

WILKINSON

P 2001

2-28-77

MISSISSIPPI  
 BOARD OF WATER COMMISSIONERS  
 416 North State Street  
 145 Jackson, Mississippi 39201

18

WATER WELL DRILLERS LOG

Feb 28 1977  
date well completed

Recess well Co  
firm name

Wilkinson  
county well located

LANDOWNER:  
 Norman Chappin  
 Weadville  
 (mailing address)

description of formations encountered	from	to
Red Shell	0	18
Red shell	18	30
pink shell	30	70
Coarse sand	70	82
lumpy	82	100
Coarse sand	100	112

WELL LOCATION:  
 sec. 6 T-1 N R-14 E  
 in miles of Pond  
 (distance) (direction) (nearest town)

WELL PURPOSE: home  
 (home, irrigation, municipal, industrial)

WELL COMPLETION DATA:  
 (1) diameter (inches) 4"  
 (2) total depth (feet) 112  
 (3) static water level (feet) 76 below above top of ground.  
 (4) casing plastic, bottom (material) (depth)  
 (size) if telescope see back.  
 (5) screen 5' 107 (length) (depth to top)  
 4" plastic (size) (material)  
 (6) pump 2 sub 10 (HP) (yield gpm)  
 belt (type power)  
 (7) electric log NO (yes or no)  
 (organization running log)


(8) how well bottom plugged  
 well bottom plug  
 DRILLERS REMARKS:

RECEIVED  
 MAR 21 1977

MISS. BD. OF WATER COMM

If well telescopes please  
sketch and show depths.

GROUND LEVEL

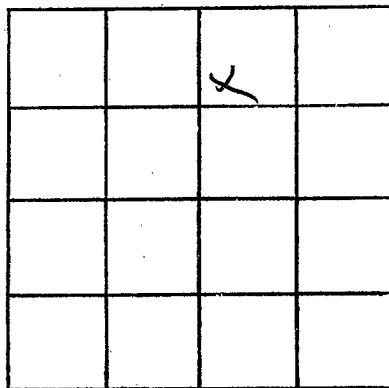

SECTION 6

Please indicate well location X.

ADDITIONAL INFORMATION

If more than one screen,  
show locations of each on sketch.