

MISSISSIPPI DEPARTMENT OF NATURAL RESOURCES

Bureau of Land and Water Resources

Southport Mall

P.O. Box 10631

Jackson, Mississippi 39209

WATER WELL DRILLERS LOG

Wilkinson
P 2002

12-3
date well completed

1982 Rayburn Drilling
firm name

Wilkinson
county well located

LANDOWNER:
B.H. Fortenberry
Natchez, Mo.
(mailing address)

description of formations encountered	from	to
	<u>top</u>	<u>0</u>
<u>gumbo</u>	<u>5</u>	<u>280</u>
<u>sand</u>	<u>280</u>	<u>300</u>
<u>gumbo</u>	<u>300</u>	<u>630</u>
<u>sand</u>	<u>630</u>	<u>663</u>

WELL LOCATION:
sec. 15 T. 1 (N) S R. 4 (E) W
1 miles (distance) SE (direction) of POWERS (nearest town)

WELL PURPOSE:
(home, irrigation, municipal, industrial)

WELL COMPLETION DATA:
(1) diameter (inches) 3"
(2) total depth (feet) 663'
(3) static water level (feet) 370 (below/above top of ground)
(4) casing (material) 3" (depth) 643'
3" (size) if telescope see back.
(5) screen 20' (length) 643 (depth to top)
3" (size) slotted pipe (material)
(6) pump - (HP) 50 (yield gpm)
elc (type power)
(7) electric log - (yes or no)
(organization running log)

Brandon #1

DEPT. OF NATURAL RESOURCES
BUREAU OF LAND & WATER RESOURCES

(8) how well bottom plugged wood plug


DEC 10 1982

RECEIVED

DRILLERS REMARKS:

If well telescopes please
sketch and show depths.

GROUND LEVEL

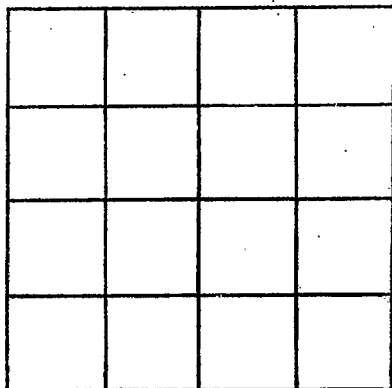

SECTION _____

Please indicate well location X.

ADDITIONAL INFORMATION

If more than one screen,
show locations of each on sketch.