

MISSISSIPPI DEPARTMENT OF NATURAL RESOURCES

Bureau of Land and Water Resources

Southport Mall

P.O. Box 10631

Jackson, Mississippi 39209

WATER WELL DRILLERS LOG

Wilbers
Paul

5-13
date well completed

1982 *Rayborn Drill & Cond. Wilkinson*
firm name

county well located

LANDOWNER:
Rayborn Drill
Natchez MS
(mailing address)

| description of formations encountered | from | to |
|---------------------------------------|-----------|------------|
| <i>Top soil</i> | <i>0</i> | <i>2</i> |
| <i>Clay</i> | <i>2</i> | <i>50</i> |
| <i>Sand</i> | <i>50</i> | <i>128</i> |

WELL LOCATION:
sec. *5* T *10* N R *4* E
S W
miles of (distance) (direction) (nearest town)

WELL PURPOSE:
(home, irrigation, municipal, industrial)

- WELL COMPLETION DATA:
- (1) diameter (inches) *2"*
 - (2) total depth (feet) *128'*
 - (3) static water level (feet) *30'* below top of ground.
 - (4) casing *PVC* *128'*
(material) (depth)
2"
(size) If telescope see back.
 - (5) screen *30'* *108'*
(length) (depth to top)
3" *PVC*
(size) (material)
 - (6) pump *50*
(HP) (yield gpm)
 - (7) electric log *no*
(yes or no)
 - (8) how well bottom plugged *wood Plug*

Struck 5-15 #1

DEPT. OF NATURAL RESOURCES
BUREAU OF LAND & WATER RESOURCES


MAY 21 1982

RECEIVED

DRILLERS REMARKS:

If well telescopes please
sketch and show depths.

GROUND LEVEL

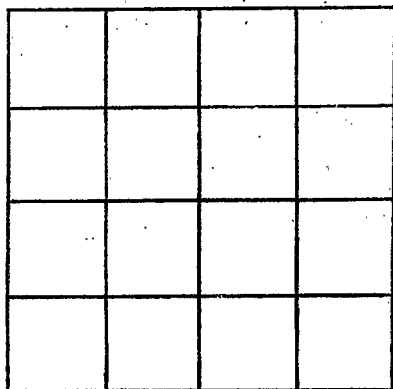

SECTION _____

Please indicate well location X.

ADDITIONAL INFORMATION

If more than one screen,
show locations of each on sketch.