

WILKINSON
P 2005

MISSISSIPPI DEPARTMENT OF NATURAL RESOURCES
Bureau of Land and Water Resources
Southport Mall
P.O. Box 10631
Jackson, Mississippi 39209
WATER WELL DRILLERS LOG

CODED

7/28 1986 Rayborn Drlg Co. Wilkinson
date well completed firm name county well located

LANDOWNER: <u>Sealand Drlg Co.</u>	description of formations encountered	from	to
<u>900 Dunn St.</u>			
<u>Houma LA 70360</u> (mailing address)	<u>Top Soil</u>	<u>0</u>	<u>15</u>
WELL LOCATION: sec. <u>20</u> T <u>1</u> N R <u>4</u> E <u>3</u> miles <u>N</u> of <u>Pincknewills</u> (distance) (direction) (nearest town)	<u>Clay</u>	<u>80</u>	<u>135</u>
WELL PURPOSE: <u>oilfield</u> (home, irrigation, municipal, industrial)	<u>Sand</u>	<u>135</u>	<u>140</u>
WELL COMPLETION DATA: (1) diameter (inches) <u>4"</u>	<u>Clay</u>	<u>140</u>	<u>290</u>
(2) total depth (feet) <u>320'</u>	<u>Sand</u>	<u>290</u>	<u>320</u>
(3) static water level (feet) <u>80</u> <u>below</u> top of ground.			
(4) casing <u>Black PVC Pipe</u> , <u>300'</u> (material) (depth)			
<u>4"</u> If telescope see back. (size)			
(5) screen <u>20'</u> , <u>300'</u> (length) (depth to top)			
<u>4"</u> , <u>Black PVC Slotted Pipe</u> (size) (material)			
(6) pump <u>5</u> <u>80</u> (HP) (yield gpm)			
<u>electric</u> (type power)			
(7) electric log <u>no</u> (yes or no)			
<u></u> (organization running log)			
(8) how well bottom plugged <u>wood</u>			

CODED


RECEIVED
SEP 19 1986

Department of Natural Resources
Bureau of Land & Water Resources

DRILLERS REMARKS:

If well telescopes please sketch and show depths.

GROUND LEVEL

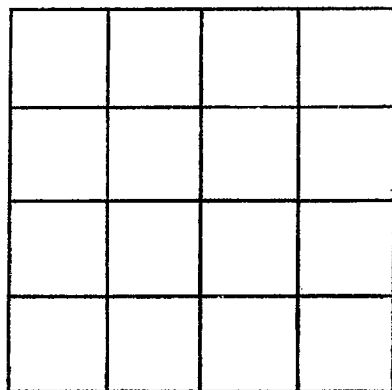

SECTION _____

Please indicate well location X.

ADDITIONAL INFORMATION

If more than one screen, show locations of each on sketch.