

MISSISSIPPI DEPARTMENT OF NATURAL RESOURCES

Bureau of Land and Water Resources

~~Southport Hall~~

P.O. Box 10631

Jackson, Mississippi 39209

WATER WELL DRILLERS LOG

D 2000
WILKINS DR

9-20 - 19 89 O.J. Harris Well Service

date well completed

firm name

county well located


LANDOWNER: <u>Shamrock Drilling</u> <u>P.O. Box 2210</u> <u>Natchez MS 39120</u> (mailing address)	description of formations encountered	from	to
WELL LOCATION: <u>J</u> sec. <u>6</u> T <u>N</u> R <u>1</u> E part <u>S</u> W, <u>ADAMS</u> <u>6</u> miles <u>East</u> of <u>Natchez</u> (distance) (direction) (nearest town)	<u>loam</u> <u>silt</u> <u>coars & sand</u>	<u>0</u> <u>42</u> <u>100</u>	<u>49</u> <u>100</u> <u>115</u>
WELL PURPOSE: <u>ria supply</u> (home, irrigation, municipal, industrial)			
WELL COMPLETION DATA: (1) diameter (inches) <u>3</u> (2) total depth (feet) <u>115</u> (3) static water level (feet) <u>14</u> below above top of ground. (4) casing <u>PVC</u> , <u>1.05</u> (material) (depth) <u> </u> If telescope see back. (size) (5) screen <u>10</u> , <u>1.05</u> (length) (depth to top) <u>3 in.</u> , <u>plastic</u> (size) (material) (6) pump <u> </u> (HP) <u> </u> (yield gpm) <u>A/S</u> (type power) (7) electric log <u>NO</u> (yes or no) <u> </u> (organization running log) (8) how well bottom plugged <u>pvc cap</u>			
DRILLERS REMARKS: <u>W</u> <u> </u> <u> </u> <u> </u>			

RECEIVED
OCT 09 1989

Department of Natural Resources
Bureau of Land & Water Resources

If well telescopes please
sketch and show depths.

GROUND LEVEL

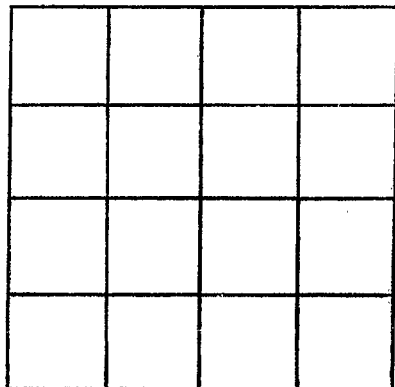

SECTION _____

Please indicate well location X.

ADDITIONAL INFORMATION

If more than one screen,
show locations of each on sketch.