

WILKINSON
Q
6-30-72

MISSISSIPPI
 BOARD OF WATER COMMISSIONERS
 416 North State Street
 Jackson, Mississippi 39201

WATER WELL DRILLERS LOG

6-30 1972 *Green Water Well Serv. Wilkerson*
 date well completed firm name county well located


LANDOWNER:	description of formations encountered	from	to
<i>Symore Lewis</i> <i>#2 Box 450</i> <i>Woodville, Miss. 39669</i> (mailing address)		<i>Top Soil</i> <i>clay</i> <i>Sand</i>	<i>0</i> <i>2</i> <i>106</i>
WELL LOCATION: sec. <u>9</u> T. <u>10</u> S. R. <u>3</u> E. <u>4</u> miles <u>SW</u> of <u>Woodville</u> (distance) (direction) (nearest town)			
WELL PURPOSE: <u>home</u> (home, irrigation, municipal, industrial)			
WELL COMPLETION DATA:			
(1) diameter (inches) <u>2"</u>			
(2) total depth (feet) <u>133'</u>			
(3) static water level (feet) <u>95'</u> below top of ground.			
(4) casing <u>Galv.</u> <u>136'</u> (material) (depth) <u>2"</u> (size) if telescope see back.			
(5) screen <u>5'</u> <u>126'</u> (length) (depth to top) <u>2"</u> "SS" (size) (material)			
(6) pump <u>1</u> <u>(5 Gpm)</u> (HP) (yield gpm) <u>elec.</u> (type power)			
(7) electric log <u>no</u> (yes or no)			
(organization running log)			
(8) how well bottom plugged <u>Good Plug</u>			
DRILLERS REMARKS:			

APR 14 1972

MISS. BD. OF
 WATER COMMISSIONERS

If well telescopes please sketch and show depths.

GROUND LEVEL

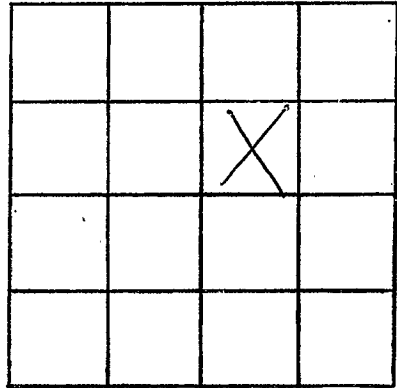

SECTION 9

Please indicate well location X.

ADDITIONAL INFORMATION

If more than one screen, show locations of each on sketch.