

Wilkinson

Q2

11-66

MISSISSIPPI
BOARD OF WATER COMMISSIONERS
416 North State Street
Jackson, Mississippi 39201

WATER WELL DRILLERS LOG

NOV. 16 1966 Keever's Well Drilling Wilkinson
 date well completed firm name county well located

LANDOWNER: LAMINIA RANCH
Woodville, Miss

description of formations encountered	from	to
white chalk	0	21
red sand (clay)	21	31
blue chalk	31	205
fine sand	125	150
coarse sand	150	162

(mailing address)

WELL LOCATION:

sec. 27 T. 10 N. R. 3 E. S. W
10 miles S.W. Woodville
 (distance) (direction) (nearest town)


WELL PURPOSE: domestic
 (home, irrigation, municipal, industrial)

WELL COMPLETION DATA:

- (1) diameter (inches) 4"
- (2) total depth (feet) 162
- (3) static water level (feet) 18 below above top of ground.
- (4) casing Plastic, 162
 (material) (depth)
- ~~(5) if telescope size back~~
- (5) screen 6' 150'
 (length) (depth to top)
4" Plastic
 (size) (material)
- (6) pump 1/2 15
 (HP) (yield gpm)
Electric
 (type power)
- (7) electric log no
 (yes or no)
- (organization running log)

(8) how well bottom plugged wooden
plug

DRILLERS REMARKS:
new location

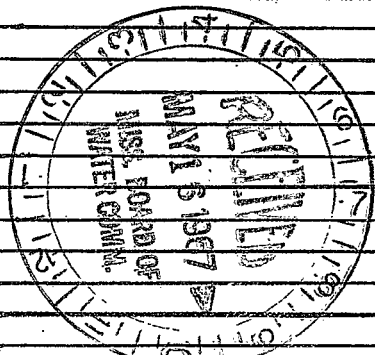


CODED

CODED

CODED

If well telescopes please sketch and show depths.

GROUND LEVEL

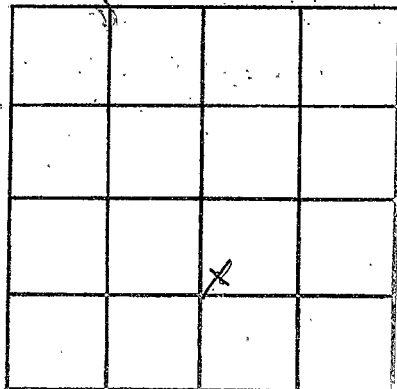

SECTION _____

Please indicate well location X.

ADDITIONAL INFORMATION

If more than one screen, show locations of each on sketch.