

WILKINSON  
Q3  
1-14-70

MISSISSIPPI  
BOARD OF WATER COMMISSIONERS  
416 North State Street  
Jackson, Mississippi 39201

CODED

WATER WELL DRILLERS LOG

1-14 1970 Griner water well in Wilkinson  
date well completed firm name county well located

LANDOWNER:  
Benjamin Davis  
Woodville, Miss.  
(mailing address)

description of formations encountered	from	to
<u>Top soil</u>	<u>0</u>	<u>2</u>
<u>Red clay</u>	<u>2</u>	<u>8</u>
<u>Sand</u>	<u>8</u>	<u>60</u>
<u>Gravel</u>	<u>60</u>	<u>100</u>
<u>Sand</u>	<u>100</u>	<u>135</u>

WELL LOCATION:  
sec. 9 T. 1 N. R. 3 E.  
5 miles SW of Woodville  
(distance) (direction) (nearest town)

WELL PURPOSE: home  
(home, irrigation, municipal, industrial)

CODED

WELL COMPLETION DATA:

(1) diameter (inches) 2"

(2) total depth (feet) 135'

(3) static water level (feet) 95' below above top of ground.

(4) casing Galv. 128'  
(material) (depth)  
2" if telescope see back.  
(size)

(5) screen 5' 128'  
(length) (depth to top)  
2" S.S.  
(size) (material)

(6) pump 1/2 7  
(HP) (yield gpm)  
electric  
(type power)

(7) electric log no.  
(yes or no)

(organization running log)

(8) how well bottom plugged well plug


DRILLERS REMARKS:

FEB 5 1970

MISS. DIV. OF WATER CONTROL

If well telescopes please sketch and show depths.

GROUND LEVEL

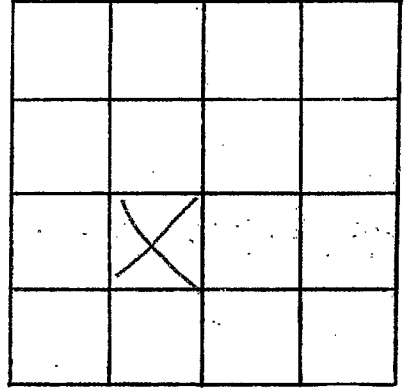

SECTION 9

Please indicate well location X.

ADDITIONAL INFORMATION

If more than one screen,  
show locations of each on sketch.