

WILKINSON
Q-5
7-26-71

MISSISSIPPI
 BOARD OF WATER COMMISSIONERS
 416 North State Street
 Jackson, Mississippi 39201

WATER WELL DRILLERS LOG

CODED

7-26 19 71 House water well Ser
 date well completed firm name county well located

LANDOWNER:
~~Beulah Payne~~ Beulah Payne
Woodville, Miss.
 (mailing address)

| description of formations encountered | from | to |
|---------------------------------------|------|-----|
| Top soil | 0 | 1 |
| Top soil | 0 | 1 |
| red clay | 1 | 9 |
| Blue clay | 9 | 83 |
| Sand | 83 | 105 |

WELL LOCATION:
 sec. 2 T. 1 N. R. 3 E
6 miles SW of Woodville
 (distance) (direction) (nearest town)

WELL PURPOSE: Home
 (home, irrigation, municipal, industrial)

- WELL COMPLETION DATA:
- (1) diameter (inches) 2"
 - (2) total depth (feet) 105'
 - (3) static water level (feet) 60' below above top of ground.
 - (4) casing Gals. 98'
 (material) (depth)
2" if telescope see back.
 (size)
 - (5) screen 5' 98'
 (length) (depth to top)
2" SS
 (size) (material)
 - (6) pump 1/2 5 GPM
 (HP) (yield gpm)
elc
 (type power)
 - (7) electric log no
 (yes or no)

CODED

(organization running log)

(8) how well bottom plugged Wood clay


SEP 15 1971

MISS. BD. OF WATER COMMISSIONERS

DRILLERS REMARKS:

If well telescopes please sketch and show depths.

GROUND LEVEL

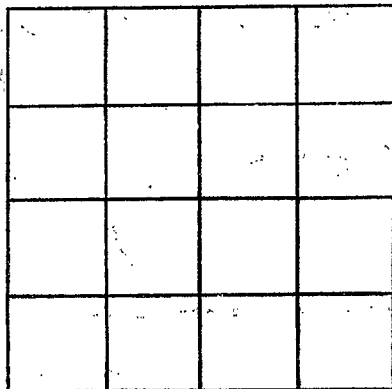

SECTION _____

Please indicate well location X.

ADDITIONAL INFORMATION

If more than one screen,
show locations of each on sketch.