

CODED

MISSISSIPPI
BOARD OF WATER COMMISSIONERS
416 North State Street
Jackson, Mississippi 39201

FEB 17 1972

MISS. BD. OF
W.

WATER WELL DRILLERS LOG

WILKINSON
Q6
1-6-72

6 Jan 1972 S.P. Waterwell Wilkinson
date well completed firm name county well located

LANDOWNER:
Lindsay Brown
Woodville
(mailing address)

description of formations encountered	from	to
<u>Clay</u>	<u>0</u>	<u>20</u>
<u>Chalk</u>	<u>20</u>	<u>60</u>
<u>Sand</u>	<u>60</u>	<u>80</u>

WELL LOCATION:
sec. 2 T. 1 N. R. 3 E
9 miles W of Woodville
(distance) (direction) (nearest town)

WELL PURPOSE:
(home, irrigation, municipal, industrial)


- WELL COMPLETION DATA:
- (1) diameter (inches) 4
 - (2) total depth (feet) 80
 - (3) static water level (feet) 65 below above top of ground.
 - (4) casing PI 74
(material) (depth)
4 if telescope see back.
(size)
 - (5) screen 6 74
(length) (depth to top)
4 PI
(size) (material)
 - (6) pump 1/2 8
(HP) (yield gpm)
elect
(type power)
 - (7) electric log (yes or no) _____
(organization running log) _____
 - (8) how well bottom plugged wood

CODED

DRILLERS REMARKS:

If well telescopes please sketch and show depths.

GROUND LEVEL

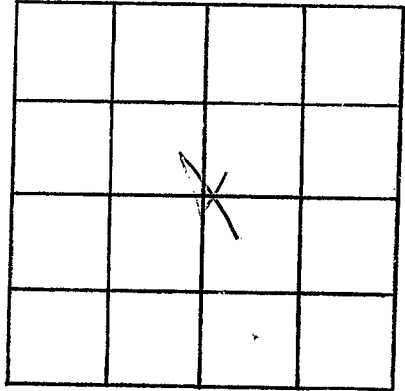

SECTION 2

Please indicate well location X.

ADDITIONAL INFORMATION

W

If more than one screen, show locations of each on sketch.