

WILKINSON
Q 7
6-20-72

MISSISSIPPI
 BOARD OF WATER COMMISSIONERS
 416 North State Street
 Jackson, Mississippi 39201

WATER WELL DRILLERS LOG

6-20 1972 Grines water well Wilkinson
 date well completed firm name county well located


LANDOWNER:	description of formations encountered	from	to
<u>Inne Steward</u> <u>Rt 2 Box 110</u> <u>Woodville, Miss</u> (mailing address)	<u>Top Soil</u> <u>Clay</u> <u>Sand</u>	<u>0</u> <u>2</u> <u>90</u>	<u>2</u> <u>90</u> <u>126</u>
WELL LOCATION:			
sec. <u>9</u> T. <u>10</u> N. R. <u>3</u> E. <u>W</u> <u>4</u> miles <u>SW</u> of <u>Woodville</u> (distance) (direction) (nearest town)			
WELL PURPOSE: <u>Home</u> (home, irrigation, municipal, industrial)			
WELL COMPLETION DATA:			
(1) diameter (inches) <u>2"</u>			
(2) total depth (feet) <u>130'</u>			
(3) static water level (feet) <u>93'</u> <u>below</u> above top of ground.			
(4) casing <u>Galv.</u> <u>119'</u> (material) (depth)			
<u>2"</u> If telescope see back. (size)			
(5) screen <u>5'</u> <u>119'</u> (length) (depth to top)			
<u>2'</u> <u>SS</u> (size) (material)			
(6) pump <u>1</u> <u>6 GPM</u> (HP) (yield gpm)			
<u>elec</u> (type power)			
(7) electric log <u>no</u> (yes or no)			
(organization running log)			
(8) how well bottom plugged <u>wood plug</u>			
DRILLERS REMARKS:			

JUL 12 1972

MISSISSIPPI BOARD OF WATER COMMISSIONERS
 JACKSON, MISSISSIPPI

If well telescopes please sketch and show depths.

GROUND LEVEL

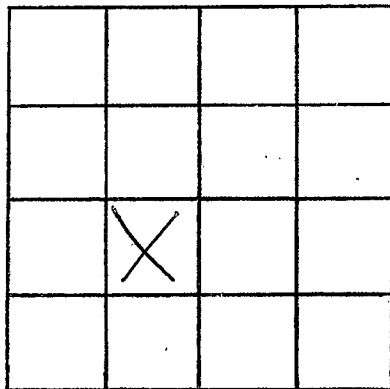

SECTION 9

Please indicate well location X.

ADDITIONAL INFORMATION

If more than one screen,
show locations of each on sketch.