

CODED

WILKINSON

Q 8

3-8-73

3-8

date well completed

WATER WELL DRILLERS LOG

1973 Haines water well Sen. Wilkinson

firm name

county well located

LANDOWNER:

L. T. Earl

Woodville, Miss.
(mailing address)

description of formations encountered

from to

TOP SOIL	0	2
Grey clay	2	60
Fine sand	60	80
Blue clay	80	95
COARSE SAND	95	147

WELL LOCATION:

sec. 20 T. 1 (N) R. 3 E (W)

5 1/2 miles SW of Woodville
(distance) (direction) (nearest town)

WELL PURPOSE: Home
(home, irrigation, municipal, industrial)

WELL COMPLETION DATA:

- (1) diameter (inches) 2"
- (2) total depth (feet) 147'
- (3) static water level (feet) 80' below above top of ground.
- (4) casing Galv. (material), 112' (depth)
2" (size) if telescope see back.
- (5) screen 5' (length), 142' (depth to top)
2" (size), 55" (material)
- (6) pump 1 (HP), 6 GPM (yield gpm)
elec (type power)
- (7) electric log no (yes or no)

CODED


(organization running log)

(8) how well bottom plugged wood plug

DRILLERS REMARKS:

If well telescopes please sketch and show depths.

GROUND LEVEL

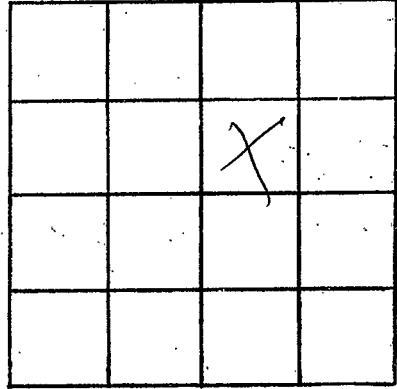

SECTION 20

Please indicate well location X.

ADDITIONAL INFORMATION

If more than one screen, show locations of each on sketch.