

MISSISSIPPI DEPARTMENT OF NATURAL RESOURCES

Bureau of Land and Water Resources

Southport Mall

P.O. Box 10631

Jackson, Mississippi 39209

WATER WELL DRILLERS LOG

CODED

WILKINSON
Q 14
4-8-81

4-8 1981 Rayborn Drill & Const. Co. Wilkinson
date well completed firm name county well located

1023' N of 490' E of SW corner

LANDOWNER:
Parco Drilling Co.
Hatchez, Ms.
(mailing address)

WELL LOCATION:
sec 20 T 10 R 3 E
12 miles SW of Wadley
(distance) (direction) (nearest town)


WELL PURPOSE:
(home, irrigation, municipal, industrial)

- WELL COMPLETION DATA:
- (1) diameter (inches) 3"
 - (2) total depth (feet) 500'
 - (3) static water level (feet) 200' below above top of ground.
 - (4) casing blc 500'
(material) (depth)
3"
(size) if telescope see back.
 - (5) screen
(length) (depth to top)
(size) (material)
 - (6) pump 1 40 GPM
(HP) (yield gpm)
(type power)
 - (7) electric log no
(yes or no)
(organization running log)
 - (8) how well bottom plugged wool plug

description of formations encountered	from	to
Top soil	0	2
Sand & pea gravel	2	110
Shale	110	285
Sand	285	310
Shale	310	330
Sand	330	340
Shale	340	420
Shale & streak of sand	420	450
Sand	450	500

CODED

Stalled pipe
481

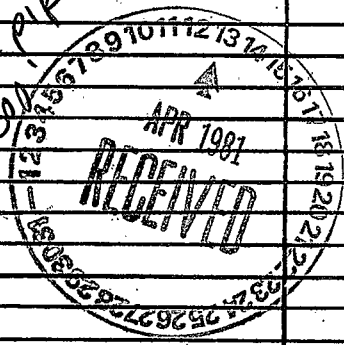

DEPT. OF NATURAL RESOURCES
BUREAU OF LAND & WATER RESOURCES


APR 13 1981

RECEIVED

DRILLERS REMARKS:

If well telescopes please
sketch and show depths.

GROUND LEVEL

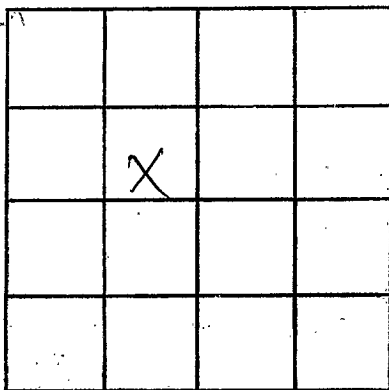

SECTION 20

Please indicate well location X.

ADDITIONAL INFORMATION

If more than one screen,
show locations of each on sketch.