

MISSISSIPPI DEPARTMENT OF NATURAL RESOURCES

Bureau of Land and Water Resources

Southport Mall

P.O. Box 10631

Jackson, Mississippi 39209

WATER WELL DRILLERS LOG


CODED

Walters
Q 16
6-23-81

6-23 1981 Rayborn Drilling & Const. Co. Walters
 date well completed firm name county well located

LANDOWNER:	description of formations encountered	from	to
<u>Adco Producing Co.</u>	<u>Top soil</u>	<u>0</u>	<u>2</u>
<u>Natchez, Ms. 39120</u> (mailing address)	<u>Sand</u>	<u>20</u>	<u>110</u>
WELL LOCATION: ? 15 sec. <u>18</u> T <u>10</u> N R <u>3</u> E <u>8</u> miles <u>SW</u> of <u>Woodville</u> (distance) (direction) (nearest town)	<u>Shale</u>	<u>110</u>	<u>330</u>
	<u>Sand</u>	<u>330</u>	<u>340</u>
	<u>Shale</u>	<u>340</u>	<u>360</u>
WELL PURPOSE: (home, irrigation, municipal, industrial)	<u>Shale & Sand</u>	<u>360</u>	<u>425</u>
WELL COMPLETION DATA:	<u>Sand</u>	<u>425</u>	<u>435</u>
(1) diameter (inches) <u>3"</u>	<u>Shale & Sand</u>	<u>435</u>	<u>577</u>
(2) total depth (feet) <u>635'</u>	<u>Sand</u>	<u>577</u>	<u>635</u>
(3) static water level (feet) _____ below above top of ground.			
(4) casing <u>Blk</u> <u>615'</u> (material) (depth)			
<u>3"</u> (size) if telescope see back.			
(5) screen <u>20'</u> <u>615'</u> (length) (depth to top)			
<u>3"</u> <u>slatted pipe</u> (size) (material)			
(6) pump _____ <u>40 GPM</u> (HP) (yield gpm)			
(type power) _____			
(7) electric log <u>no</u> (yes or no)			
(organization running log) _____			
(8) how well bottom plugged <u>wood plug</u>			
DRILLERS REMARKS:			


Fr NW/cor Sec. 16 of chur
 S 1/4 L between Sec.
 14 & 16 and extend there of
 3093' to locatin Sec. 10, 15

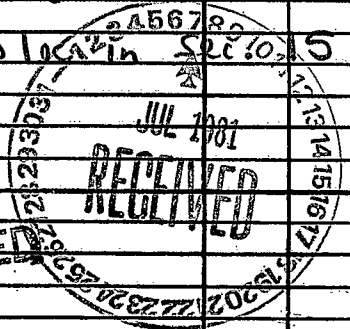

CODED

If well telescopes please sketch and show depths.

GROUND LEVEL

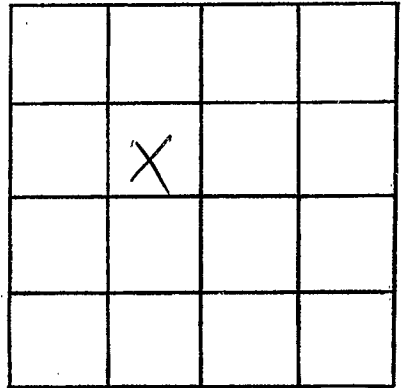

SECTION 18

Please indicate well location X.

ADDITIONAL INFORMATION

If more than one screen,
show locations of each on sketch.