

MISSISSIPPI DEPARTMENT OF NATURAL RESOURCES

Bureau of Land and Water Resources

Southport Mall

P.O. Box 10631

Jackson, Mississippi 39209

WATER WELL DRILLERS LOG

WILKINSON
Q17
11/7/82

Nov. 7 1982 Brunfield Well Service Wilkinson
date well completed firm name county well located

LANDOWNER:
Energy Drilling Co
Liberty Rd Natchez
(mailing address)

description of formations encountered	from	to
Surface Clay	0	25
Red Sand	25	35
White Chalk	35	123
Sand	123	163
Course Sand	163	203

WELL LOCATION:
sec 28 T 1 N R 3 W
0.2 miles SW of Woodville
(distance) (direction) (nearest town)

EXXON Corp, #1 WYOMING, IN unit 4, FR sub/co sec 21 ga E'LY abt sec 123 224'. 7th 3' D RA 3306' to loc in 1 sec 28, T1N, R3W

WELL PURPOSE: For Oil Well
(home, irrigation, municipal, industrial)

- WELL COMPLETION DATA:
- (1) diameter (inches) 3"
 - (2) total depth (feet) 203'
 - (3) static water level (feet) 10' below top of ground.
 - (4) casing Steel, 187'
(material) (depth)
3" if telescope see back.
(size)
 - (5) screen 16', 187'
(length) (depth to top)
3", Steel
(size) (material)
 - (6) pump Air, 70
(HP) (yield gpm)
Diesel
(type power)
 - (7) electric log No
(yes or no)
(organization running log)
 - (8) how well bottom plugged Cap

CODED
CODED
NOV 16 1982


DRILLERS REMARKS:

RECEIVED

DEPT. OF NATURAL RESOURCES
BUREAU OF LAND & WATER RESOURCES

If well telescopes please sketch and show depths.

GROUND LEVEL

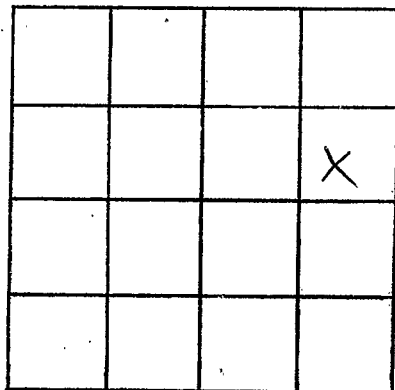

SECTION 28

Please indicate well location X.

ADDITIONAL INFORMATION

If more than one screen,
show locations of each on sketch.