

MISSISSIPPI DEPARTMENT OF NATURAL RESOURCES

Bureau of Land and Water Resources

Southport Mall

P.O. Box 10631

CODED

Jackson, Mississippi 39209

WATER WELL DRILLERS LOG

Q18
Wilkinson
10-3-83

10-3 1983 Rayborn Drill. & Const. Co. Wilkinson
date well completed firm name county well located

LANDOWNER:
B. H. Fortenberry
Natchez, MS. 39120
(mailing address)

description of formations encountered	from	to
Top soil	0	10
Clay	10	60
Sand & pea gravel	60	110
gumbo	110	350
Break sand & gravel	350	470
Sand	470	570

WELL LOCATION:
sec. 19 T-10 S R-3 E
(distance) miles (direction) of (nearest town)

WELL PURPOSE:
(home, irrigation, municipal, industrial)

WELL COMPLETION DATA:

(1) diameter (inches) 3"

(2) total depth (feet) 510'

(3) static water level (feet) 300' below top of ground.

(4) casing 3" (size) if telescope see back.
Belc #90' (material) (depth)

(5) screen 3" (size), 490' (length), (depth to top)
3" (size), slotted pipe (material)

(6) pump (HP) 52 GPM (yield gpm)

(7) electric log (yes or no)

(8) how well bottom plugged wood plug

1470' N + 4302' W of SE COR
Sec 19-N-3W

Oxygen #1

DEPT. OF NATURAL RESOURCES
BUREAU OF LAND & WATER RESOURCES


OCT 11 1983

RECEIVED

DRILLERS REMARKS:

If well telescopes please sketch and show depths.

GROUND LEVEL

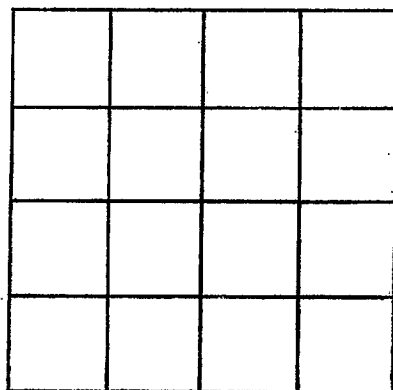

SECTION _____

Please indicate well location X.

ADDITIONAL INFORMATION

If more than one screen,
show locations of each on sketch.