

MISSISSIPPI DEPARTMENT OF NATURAL RESOURCES

Bureau of Land and Water Resources

Southport Mall

P.O. Box 10631

Jackson, Mississippi 39209

WATER WELL DRILLERS LOG

CODED

WILKINSON
Q 19

Griner Drilling Service, Inc.

Wilkinson

1-10-86
date well completed

firm name

county well located

LANDOWNER:
Quarles Drilling
1503 Engineer Road
Belle Chase, La. 70037
(mailing address)

description of formations encountered	from	to
CLAY	0	63
SAND	63	105
CLAY	105	525
SAND	525	588
STREAKED	588	693

WELL LOCATION: 4527'N & 1206'E
sec 33 T 1 N R 3 E of
No. 60 George Pinckneyville
Broussard (distance) miles (direction) (nearest town)
SW 1/4

WELL PURPOSE: oilfield supply
(home, irrigation, municipal, industrial)

WELL COMPLETION DATA:

- (1) diameter (inches) 3"
- (2) total depth (feet) 693'
- (3) static water level (feet) 220' (below top of ground. above)
- (4) casing steel 588'
(material) (depth)
3" (size) If telescope see back.
- (5) screen 42' 546'
(length) (depth to top)
3" perforated
(size) (material)
- (6) pump No 60
(HP) (yield gpm)
AC
(type power)
- (7) electric log _____
(yes or no)
(organization running log)

(8) how well bottom plugged orange peel

DRILLERS REMARKS:


CODED

RECEIVED
FEB 18 1986

Department of Natural Resources
Bureau of Land & Water Resources

If well telescopes please
sketch and show depths.

GROUND LEVEL

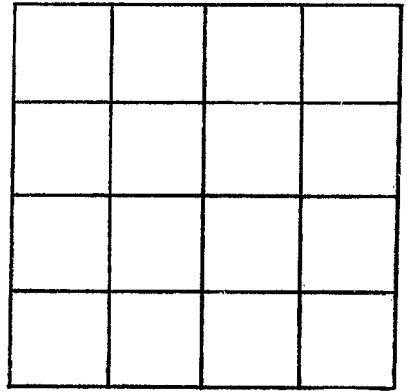

SECTION _____

Please indicate well location X.

ADDITIONAL INFORMATION

If more than one screen,
show locations of each on sketch.