

MISSISSIPPI DEPARTMENT OF NATURAL RESOURCES

Bureau of Land and Water Resources

Southport Mall

P.O. Box 10631

Jackson, Mississippi 39209

WATER WELL DRILLERS LOG

CODED

WILKINSON
Q 20

7/25 1986 Rayborn Drlg Co. Wilkinson
date well completed firm name county well located

LANDOWNER: <u>Sealand Drlg Co</u>	description of formations encountered	from	to
<u>900 Dunn St.</u>	<u>Chalk</u>	<u>0</u>	<u>190</u>
<u>Houma LA 70360</u> (mailing address)	<u>Sand</u>	<u>190</u>	<u>275</u>
CODED			
WELL LOCATION: sec. <u>33</u> T <u>1</u> N <u>3</u> E S W	#1 FREDRICK WESTPHAL ET AL		
<u>2</u> miles <u>SE</u> of <u>Plackneyville</u> (distance) (direction) (nearest town)	<u>669'S'LY @ RA FR N1/2, 684'E'LY</u>		
WELL PURPOSE: <u>oilfield</u> (home, irrigation, municipal, industrial)	<u>@ RA FR W1/1</u>		
WELL COMPLETION DATA:			
(1) diameter (inches) <u>4"</u>			
(2) total depth (feet) <u>275'</u>			
(3) static water level (feet) <u>170'</u> <u>below</u> top of ground. above			
(4) casing <u>Sch 40 PVC, 255'</u> (material) (depth)			
<u>4"</u> (size) if telescope see back.			
(5) screen <u>20'</u> , <u>255'</u> (length) (depth to top)			
<u>4"</u> , <u>Sch 40 Slotted PVC</u> (size) (material)			
(6) pump <u>5</u> <u>70</u> (HP) (yield gpm)			
<u>electric</u> (type power)			
(7) electric log <u>no</u> (yes or no)			
(organization running log)			
(8) how well bottom plugged <u>wood</u>			
DRILLERS REMARKS:			


RECEIVED
SEP 19 1986

SEP 19 1986

Department of Natural Resources
Bureau of Land & Water Resources

If well telescopes please
sketch and show depths.

GROUND LEVEL

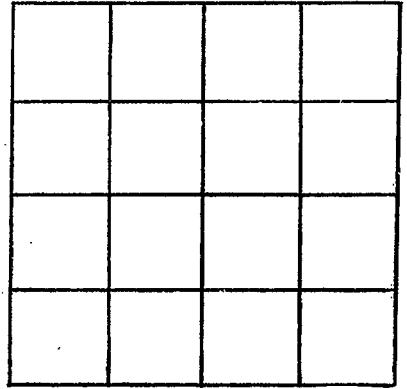

SECTION _____

Please indicate well location X.

ADDITIONAL INFORMATION

If more than one screen,
show locations of each on sketch.