

MISSISSIPPI DEPARTMENT OF NATURAL RESOURCES

Bureau of Land and Water Resources

COUNTY WELL LOCATED  
**Wilkinson**  
 WELL NUMBER CODED  
**No. 1 Holland**  
**Heirs 11**  
 DATE WELL COMPLETED  
**9-21-89**

**Q2/324**  
 PERMIT NUMBER  
 NAME OF DRILLING FIRM  
**Griner Drilling Service, Inc.**

**CODED**

P.O. Box 10631  
 Jackson, Mississippi 39209  
**WATER WELL DRILLERS LOG**

NAME & MAILING ADDRESS OF LANDOWNER  
**Pacific Enterprises**  
**First City Center**  
**Box 480 1700 Pacific Ave.**  
**Suite 1200**  
**Dallas, Texas 75201-4807**  
 WELL LOCATION: SEC TOWNSHIP RANGE  
**Sec 12, 00 11 1 0 3 (W)**  
 DISTANCE IN N. OR S. DIRECTION NEAREST TOWN  
**400' IN N. C. R. 200' TO LOC. IN Sec 11-N-3W**  
 OTHER LANDMARK  
**Pickneyville - Pond**  
 WELL PURPOSE: Home, Irrigation, Municipal, Industrial, Fish Pond, etc.  
**Oilfield rig supply**

PUMP DATA  
 PUMP TYPE (Circle One):  
 Submersible  Turbine  Other (Describe) **7 1/2 H.P.**  
 POWER TYPE (Circle One):  
 Electric  Tractor, Diesel  Gasoline  Butane   
 Other (Describe) **230 volt**  
 Pump Capacity (GPM) **75**  **3 phase**  **5 phase**   
 PUMP TEST  
 Well yielded **25** GPM with  
 a drawdown of \_\_\_\_\_ ft.  
 after \_\_\_\_\_ hours of pumping

WELL DATA  
 Well Depth **490'** Casing Diameter (In.) **4"** Casing Length (Ft.) **20'**  
 Type of Casing **PVC** Hole Depth **490'** Depth to Screen **460'**  
 TYPE OF COMPLETION: (Circle One or More):  
 Gravel Pack  Underreamed  Telescoped   
 Natural Development  Open Hole  Other   
 Top of Lap Pipe or Reduction in Casing  
 FEET IF TELESOPED OR MORE THAN ONE SCREEN: USE BACK PAGE

LOG DATA  
 TYPE OF LOG RUN (Circle One):  
 No Log Run  Electric  Gamma Ray  Density  Sonic  Neutron   
 Other (Describe) \_\_\_\_\_  
 Name of Organization Running Log

SCREEN DATA  
 Diameter - Inches **4"** Length - Feet **30'** Slot Size - Inches **.010**  
 Screen Type **PVC** Depth to Bottom - Feet **460' - 490'**

GEOLOGIC DATA (Office Use Only)  

Surface Elev.	Geologic Unit	Unit Thickness	Depth to Top
Subs. SWL	Date	Analysis	Aquifer Test

 Driller's Remarks

DESCRIPTION OF FORMATIONS ENCOUNTERED	FROM	TO
<b>clay</b>	<b>0</b>	<b>170</b>
<b>sand</b>	<b>170</b>	<b>210</b>
<b>clay</b>	<b>210</b>	<b>315</b>
<b>sand</b>	<b>315</b>	<b>335</b>
<b>sand &amp; clay</b>	<b>335</b>	<b>470</b>
<b>sand</b>	<b>470</b>	<b>490</b>


**RECEIVED**  
**OCT 30 1989**  
 Department of Natural Resources  
 Bureau of Land & Water Resources

FORMATIONS (Continued)	FROM	TO

IF MORE SPACE IS NEEDED, USE BACK.

If well telescopes please  
sketch and show depths.

GROUND LEVEL

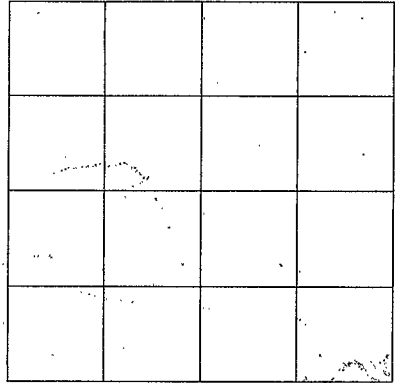

SECTION \_\_\_\_\_

Please indicate well location X.

ADDITIONAL INFORMATION

If more than one screen,  
show location of each on sketch.