

WILKINSON

MISSISSIPPI
BOARD OF WATER COMMISSIONERS
416 North State Street
Jackson, Mississippi 39201

Q
12/14/77

WATER WELL DRILLERS LOG

12-14
date well completed

19 27 Rayboon Drill & Const. Co.
firm name

Wilkinson
county well located

LANDOWNER:	description of formations encountered	from	to
Willie James Rt 2 Box 242 Woodville, MS. (mailing address)			
WELL LOCATION:	red clay	2	14
sec. 2 T. 1 N. R. 3 E. 8 miles SW of Woodville (distance) (direction) (nearest town)	blue clay	14	135
WELL PURPOSE: Home (home, irrigation, municipal, industrial)	coarse sand	135	175
WELL COMPLETION DATA:			
(1) diameter (inches) 2"			
(2) total depth (feet) 175'			
(3) static water level (feet) 86' below top of ground.			
(4) casing gal. 168' (material) (depth) 2" (size) If telescope see back.			
(5) screen 5' 168' (length) (depth to top) 2" "SS" (size) (material)			
(6) pump 1 6 (HP) (yield gpm) elec (type power)			
(7) electric log SW (yes or no)			
(organization running log)			
(8) how well bottom plugged wood clay			
DRILLERS REMARKS:			


RECEIVED

APR 20 1978

MISS. BD. OF WATER COMMISSIONERS

If well telescopes please sketch and show depths.

GROUND LEVEL

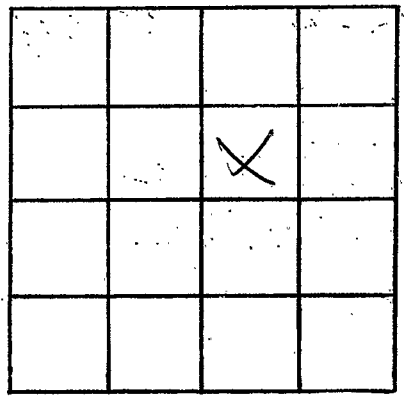

SECTION 2

Please indicate well location X.

ADDITIONAL INFORMATION

Lined area for additional information.

If more than one screen, show locations of each on sketch.