

WILKINSON

Q 2000

10-16-78

MISSISSIPPI BOARD OF WATER COMMISSIONERS
416 North State Street
Jackson, Mississippi 39201

WATER WELL DRILLERS LOG

Oct 16 1978
date well completed


Reeves Well Services
firm name

Wilkinson
county well located

LANDOWNER:	description of formations encountered	from	to
Reggie Cupit Woodville (mailing address)	Red Clay Red Chalky sand Coarse sand & pebbles	0	17 17 128 140
WELL LOCATION: sec 27 T 1 N R 3 W 7 miles SSW of Woodville (distance) (direction) (nearest town)			
WELL PURPOSE: <u>Truck</u> (home, irrigation, municipal, industrial)			
WELL COMPLETION DATA: (1) diameter (inches) <u>4'</u> (2) total depth (feet) <u>140</u> (3) static water level (feet) <u>90</u> above below top of ground. (4) casing <u>plastic bottom</u> (material) (depth) <u>✓</u> if telescope see back. (size) (5) screen <u>5'</u> <u>135'</u> (length) (depth to top) <u>4"</u> <u>plastic</u> (size) (material) (6) pump <u>2 1/2 hp</u> <u>10</u> (HP) (yield gpm) <u>shot</u> (type power) (7) electric log <u>no</u> (yes or no) <u>Miss. Board of Water Comm.</u> (organization running log)			
(8) how well bottom plugged <u>wooden plug</u> DRILLERS REMARKS:			FEB 15 1979 RECEIVED

If well telescopes please sketch and show depths.

GROUND LEVEL

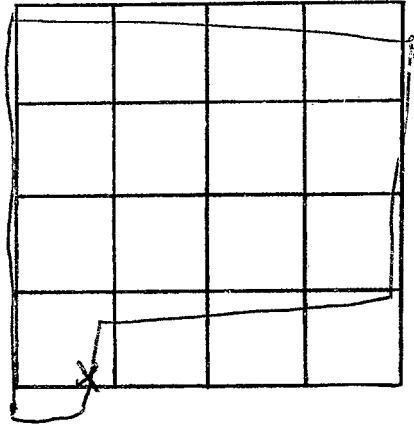

SECTION 27

Please indicate well location X.

ADDITIONAL INFORMATION

If more than one screen,
show locations of each on sketch.