

Wilkinson
 Q 2004
 3-17-81

MISSISSIPPI DEPARTMENT OF NATURAL RESOURCES
 Bureau of Land and Water Resources
 Southport Mall
 P.O. Box 10631
 Jackson, Mississippi 39209
WATER WELL DRILLERS LOG

March 17, 1981 River Valley Wilkerson
 date well completed firm name county well located


LANDOWNER:
 Vernon Dawson
 Woodville
 (mailing address)

WELL LOCATION:
 sec. 32 T-1 N R-3 E
 11 miles W.S.W. of Woodville
 (distance) (direction) (nearest town)

WELL PURPOSE: house
 (home, irrigation, municipal, industrial)

- WELL COMPLETION DATA:**
- (1) diameter (inches) 4"
 - (2) total depth (feet) 184'
 - (3) static water level (feet) 140' below top of ground.
 - (4) casing plastic bottom (material) (depth)
 - (size) if telescope see back.
 - (5) screen 10' 174" (length) (depth to top)
 4" plastic (size) (material)
 - (6) pump 1/2 HP 12' (HP) (yield gpm)
 elect (type power)
 - (7) electric log no (yes or no)
 (organization running log)
 - (8) how well bottom plugged
 backwash


description of formations encountered	depth	
	from	to
Clay	0	20
yellow sand	20	65
blue gravel	65	90
white chalk	90	115
fine sand & clay	115	165
med. coarse sand	165	184

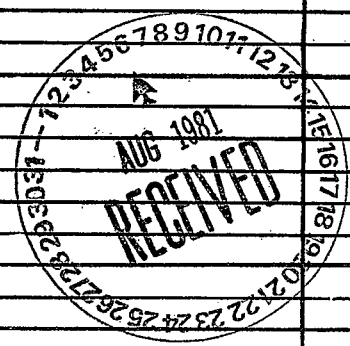

DRILLERS REMARKS:

If well telescopes please sketch and show depths.

GROUND LEVEL

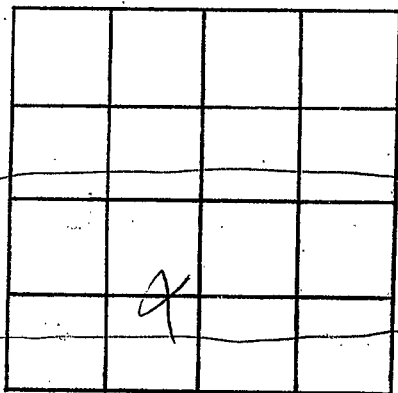

SECTION 32

Please indicate well location X.

ADDITIONAL INFORMATION

If more than one screen,
show locations of each on sketch.