

MISSISSIPPI DEPARTMENT OF NATURAL RESOURCES

Bureau of Land and Water Resources

Southport Mall

P.O. Box 10631


Jackson, Mississippi 39209

WATER WELL DRILLERS LOG

Wilkinson
Q. 2000
3-23-81


March 23 1981 Reynolds well for Wilkinson
 date well completed firm name county well located

LANDOWNER:	description of formations encountered	from	to
<u>Helen Bethley Woodruff</u> (mailing address)			
	<u>sand</u>	<u>10</u>	<u>22</u>
	<u>Red & white Chalk</u>	<u>22</u>	<u>80</u>
	<u>fine sand</u>	<u>80</u>	<u>115</u>
	<u>sand & pea gravel</u>	<u>115</u>	<u>130</u>
WELL LOCATION:			
sec. <u>2</u> T. <u>1</u> N. R. <u>3</u> E. W. <u>W</u>			
<u>0</u> miles <u>W.S.W</u> of <u>Woodville</u> (distance) (direction) (nearest town)			
WELL PURPOSE: <u>house</u> (home, irrigation, municipal, industrial)			
WELL COMPLETION DATA:			
(1) diameter (inches) <u>4"</u>			
(2) total depth (feet) <u>130</u>			
(3) static water level (feet) <u>112</u> below top of ground. <u>above</u>			
(4) casing <u>plaster bottom</u> (material) (depth)			
<u>-</u> If telescope see back. (size)			
(5) screen <u>5'</u> <u>125'</u> (length) (depth to top)			
<u>4"</u> <u>plaster</u> (size) (material)			
(6) pump <u>3/4</u> <u>10</u> (HP) (yield gpm)			
<u>split</u> (type power)			
(7) electric log <u>no</u> (yes or no)			
<u>-</u> (organization running log)			
(8) how well bottom plugged <u>Backwash</u>			
DRILLERS REMARKS:			

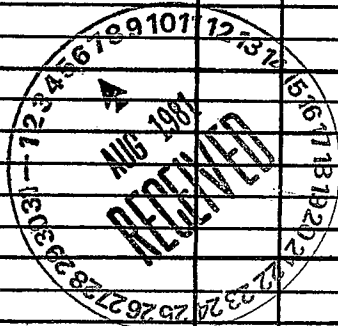

If well telescopes please sketch and show depths.

GROUND LEVEL

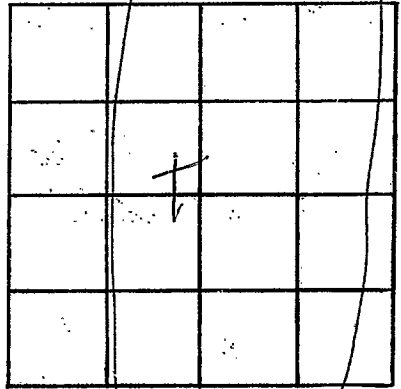

SECTION 2

Please indicate well location X.

ADDITIONAL INFORMATION

If more than one screen,
show locations of each on sketch.